


U. S. PUBLIC LAND SURVEY MONUMENT RECORD

INSTRUCTIONS: This record shall show the location of the corner and shall include all of the following nine elements (a through i).

- (a) Identify the corner by reference to the U.S. public land survey system.
 ⊕ = Corner monument restored.

South $\frac{1}{4}$ CORNER
 SECTION 31, T.5 N., R.1 W.
 TOWN OF CLIFTON
 SET $1\frac{1}{4}$ " IRON ROD

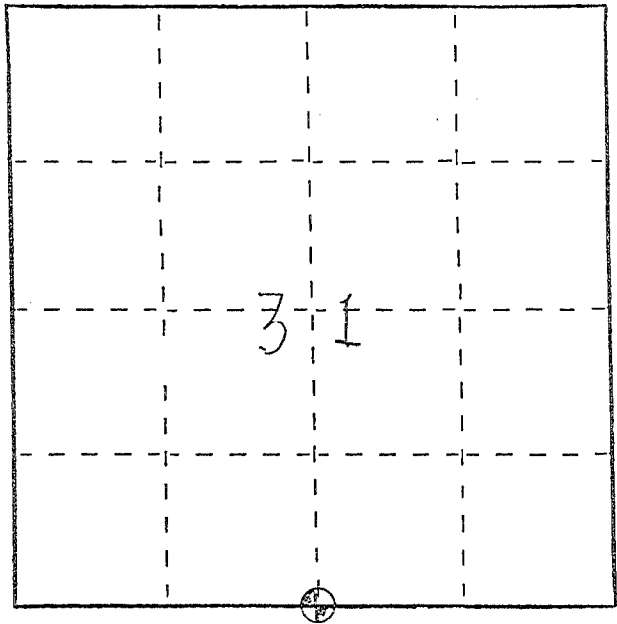


- (b) Describe any record evidence, monument evidence, occupational evidence, testimonial evidence or any other material evidence you considered, and whether the monument was found or placed.

NO RECORD OF RESURVEYS COMPLETED. I SET A $1\frac{1}{4}$ " x 30" IRON ROD AT FENCE INTERSECTION NORTH-EAST-WEST.

- (c) In the plan view drawing below, provide reference ties to at least 4 witness monuments, or, if the location is within a municipality, to at least 2 witness monuments. (Witness monuments shall be made of concrete, natural stone, iron or other equally durable material.) Describe witness monuments.

- (d) Show a plan view drawing depicting the relevant monuments and reference ties which is sufficient in detail to enable accurate relocation of the corner monument if the corner monument is disturbed. Indicate north.

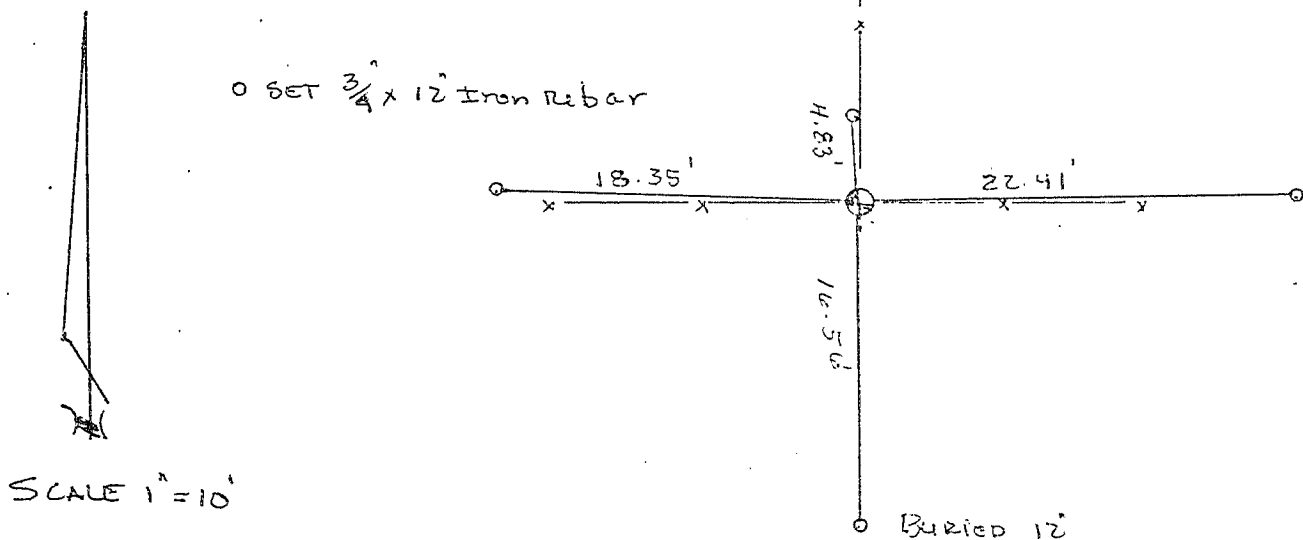

(e) Describe any material discrepancy between the location of the corner as restored or reestablished and the location of that corner as previously restored or reestablished by distance and direction. Show the discrepancy on the plan view drawing under (d), above. Show the distances between the corner as previously restored or reestablished and (1) the corner as restored or reestablished, and (2) to at least 2 of the witness monuments shown on the drawing in (d), above.

None

(f) Was the corner restored through acceptance of (1) an obliterated evidence location, or, (2) a found perpetuated location?

(1) an obliterated evidence location.

(g&h) Was the corner reestablished through lost corner proportionate methods? If so, show the method, including the directions and distances to other public land survey corners used as evidence or used for proportioning in determining the corner location?

Affix Land Surveyor Seal



(i) I, John m. HALVERSON
(type or print name) certify that the corner location shown on this record was determined by me or under my direction and control and that this U.S. Public Land Survey Monument Record is correct and complete to the best of my knowledge and belief.

John M. Halverson


5/11/02

Survey Monument Record

TYPE OF MONUMENT 3/4" x 24" IRON
BAR SET

CORNER NO. 12
SECTION 06
TOWN 14N
RANGE 11W

FIELD BOOK: 96-08
PAGE (18)

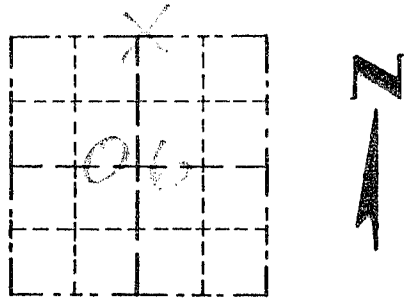

LOCATION
(Indicated by "X")


BASIS FOR MONUMENT LOCATION

(Use reverse side if necessary)

Show info such as: History of corner, with reference to Vol. and pg., dates, surveyor; exact description of monument replaced; if location computed, by taped or EDM traverse; landowner, remarks, etc.

SEAL:

CORNER WAS MEASURED TO IN 1876 BY JOEL BARBER. I SET THE CORNER AT THE RECORDED OFFSET FROM THE SOUTH 1/4 CORNER OF SECTION 31 T5N R1W. THIS FIT WELL WITH OCCUPATION. VERIFIED ITS LOCATION USING EDM METHODS.

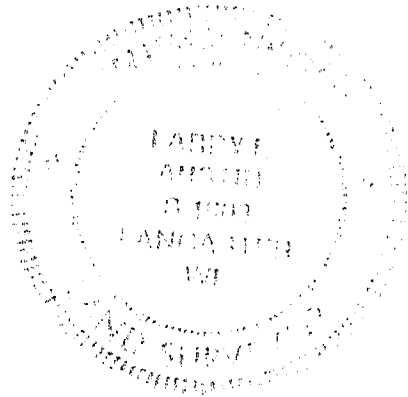

CERTIFIED CORRECT

Rory L. Post
Registered Land Surveyor

DATE: 1-16-98

TIE SKETCH

Show at least three (3) ties and monument

LEGEND

⊕ 3/4" x 24" IRON BAR SET

● 1 1/4" IRON BAR SET

XX EXISTING FENCE

