

GRANT COUNTY

Survey Monument Record

TYPE OF MONUMENT COUNTY MONUMENT
 STATE PLANE COORDINATES: N _____
 E _____
 ELEVATION — M.S.L. DATUM: _____
 THETA ANGLE: _____
 FIELD BOOK: 9504
 PAGE 27

CORNER NO. 45
 SECTION 11
 TOWN SN
 RANGE ZW
SW COR

BASIS FOR MONUMENT LOCATION

(Use reverse side if necessary)


Show info such as: History of corner, with reference to Vol. and pg., dates, surveyor; exact description of monument replaced; if location computed, by taped or EDM traverse; landowner, remarks, etc.

CORNER WAS ORIGINALLY SET IN 1832 BY PARKE; NO RECORD OF CORNER FOUND SINCE ORIGINAL SURVEYS; I SET THE CORNER EQUIDISTANT FROM THE W¹/₄ CORNER SECTION 11 & W¹/₄ CORNER SECTION 14; THE E-W LOCATION I ACCEPTED FOUND BRACE POST.



LOCATION
(Indicated by "X")

SEAL:

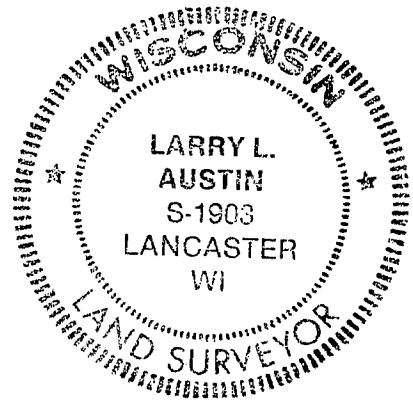

CERTIFIED CORRECT

Larry L. Austin
 Registered Land Surveyor

DATE: 10/24/95

TIE SKETCH

Show at least three (3) ties and monument

