


GRANT COUNTY

Survey Monument Record

TYPE OF MONUMENT COUNTY MONUMENT
 STATE PLANE COORDINATES: N _____
 E _____
 ELEVATION — M.S.L. DATUM: _____
 THETA ANGLE: _____
 FIELD BOOK: 9504
 PAGE 24

CORNER NO. 43
 SECTION 11
 TOWN 5 N
 RANGE 2 W
SE COR.

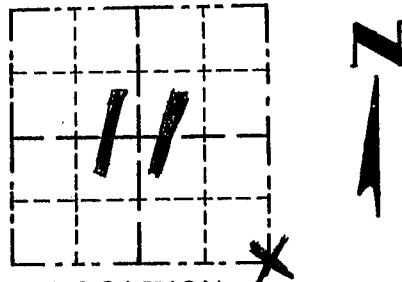

LOCATION
 (Indicated by "X")

BASIS FOR MONUMENT LOCATION


(Use reverse side if necessary)

Show info such as: History of corner, with reference to Vol. and pg., dates, surveyor; exact description of monument replaced; if location computed, by taped or EDM traverse; landowner, remarks, etc.

CORNER WAS ORIGINALLY SET IN 1832 BY PARKE.

CORNER WAS RECORDED AS BEING 40.66 CHAINS SO. OF E 1/4 CORNER ON A 1870 SURVEY BY ALLEN & 40.40 CHAINS SO. OF E 1/4 CORNER ON A 1881 SURVEY BY J.C. SCOTT. I ESTABLISHED THE N-S LOCATION BASED ON OCCUPATION AT E 1/4 COR. & THE 1870 DIMENSION - THE E-W LOCATION WAS PUT ON LINE TO THE E 1/4 CORNER OF SEC. 14. THIS LOCATION VERIFIED BY EDM TRAVERSE OF THE AREA

SEAL:

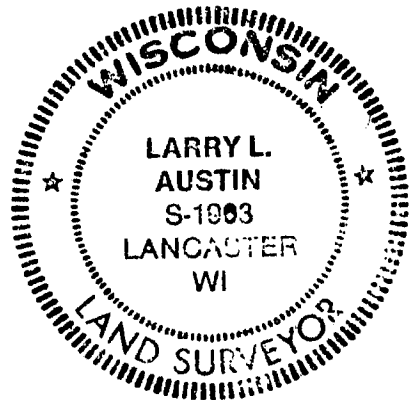

CERTIFIED CORRECT

Larry L. Austin
 Registered Land Surveyor

DATE: 10-24-95

TIE SKETCH

Show at least three (3) ties and monument

