


Survey Monument Record

TYPE OF MONUMENT 3/4" X 24" IRON BAR SET

CORNER NO. 62
 SECTION 24
 TOWN 5N
 RANGE 2W

FIELD BOOK: 96-21
 PAGE (11)

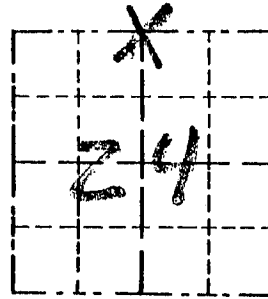

LOCATION
 (Indicated by "X")

BASIS FOR MONUMENT LOCATION

(Use reverse side if necessary)

Show info such as: History of corner, with reference to Vol. and pg., dates, surveyor; exact description of monument replaced; if location computed, by taped or EDM traverse; landowner, remarks, etc.

SEAL:



CORNER SET IN 1832 BY HARVEY CARKE. NO RECORD OF CORNER FOUND SINCE ORIGINAL SURVEYS; CORNER WAS SET MIDWAY AND ONLINE BETWEEN THE NORTHEAST AND THE NORTHWEST CORNERS OF SAID SECTION 24, T5N, R2W. VERIFIED ITS LOCATION USING EDM METHODS.

CERTIFIED CORRECT

Larry L. Austin
 Registered Land Surveyor

DATE: 2/16/97

TIE SKETCH

Show at least three (3) ties and monument

LEGEND

- 3/4" X 24" IRON BAR SET
- 1/2" X 15" IRON BAR SET
- ✕ EXISTING FENCE

