


GRANT COUNTY

Survey Monument Record

CORNER NO. 65
 SECTION 14
 TOWN 5N
 RANGE 2W
SW COR.

TYPE OF MONUMENT COUNTY MONUMENT
 STATE PLANE COORDINATES: N _____
 E _____
 ELEVATION — M.S.L. DATUM: _____
 THETA ANGLE: _____
 FIELD BOOK: 9504
 PAGE 25

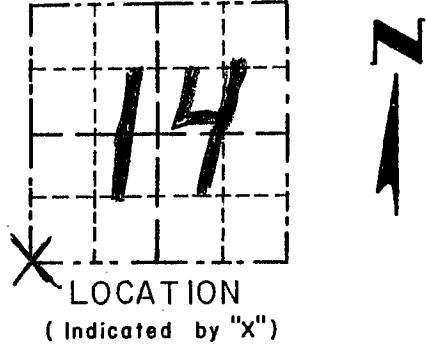

BASIS FOR MONUMENT LOCATION

(Use reverse side if necessary)
 Show info such as: History of corner, with reference to Vol. and pg., dates, surveyor; exact description of monument replaced; if location computed, by taped or EDM traverse; landowner, remarks, etc.

SEAL:

ORIGINAL CORNER SET
 IN 1832 BY PARKE.
 NO RECORD OF CORNER FOUND
 SINCE THE ORIGINAL SURVEYS,
 I PROPORTIONED THE CORNER
 E-W BETWEEN S $\frac{1}{4}$ CORNER
 SECT. 15 & S $\frac{1}{4}$ COR. SECT. 14.



CERTIFIED CORRECT
Larry L. Austin
 Registered Land Surveyor
 DATE: 10/24/95

TIE SKETCH

Show at least three (3) ties and monument

