

RECORDED


MAR 9 1988

U. S. PUBLIC LAND SURVEY MONUMENT RECORD
GRANT County, Wisconsin.

Basis for monument location.

Section 22, T 5 N, R 2

Last refernce to the corner was the original Government Survey. No evidence of the corner or its accessories could be located. I established the corner from the existing fence lines to the North, East and West. The fence from the West is at 24.75 South of the corner. This location fit very well with the travising of the Section. I monumented the corner with an iron bar and referenced it as shown.

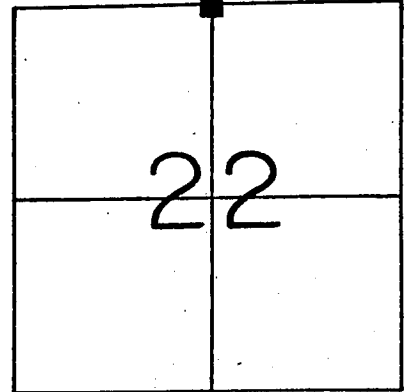

Corner Location
(Indicate by - ■)

Tie sketch

TIES 20d POLESPIKES SET IN
BLAZE AT BOTTOM
OF TREE

WOODED

CLEARED

SW/S 15" BASSWOOD

38.17'

35.36'

54.84'

NW/S 12" R. OAK

W/S 6" MAPLE

NE/S 4" W. OAK

WOODED

WOODED

I, _____ Certify that the corner location shown hereon this record was determined by me or under my direction and control and that this U. S. Public Land Survey Monument Record is correct and complete to the best of my knowledge and belief.

3-8-88
Date

Matthew J. Janiak
Registered Land Surveyor

