

GRANT COUNTY

Survey Monument Record

TYPE OF MONUMENT COUNTY MONUMENT
 STATE PLANE COORDINATES: N _____
 E _____
 ELEVATION — M.S.L. DATUM: _____
 THETA ANGLE: _____
 FIELD BOOK: 9504
 PAGE: 25

CORNER NO. 58
 SECTION 14
 TOWN 5 N
 RANGE 2 W
W 1/4 COR.



LOCATION
 (Indicated by "X")


BASIS FOR MONUMENT LOCATION

(Use reverse side if necessary)

Show info such as: History of corner, with reference to Vol. and pg., dates, surveyor; exact description of monument replaced; if location computed, by taped or EDM traverse; landowner, remarks, etc.

SEAL:

ORIGINAL CORNER SET
 IN 1832 BY PARKE.
 NO RECORD OF CORNER FOUND
 SINCE ORIGINAL SURVEYS. I
 FOUND OLD E-W. FENCE REMNANTS
 AT RECORD DIST. OF 40 ch. from
 SW CORNER OF SECT 14; SET
 A COUNTY MONUMENT AT THIS
 LOCATION.

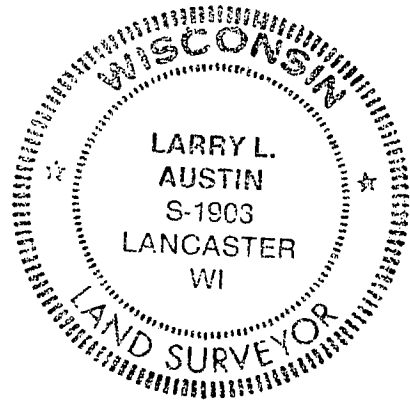

CERTIFIED CORRECT

Larry L. Austin
 Registered Land Surveyor

DATE: 10/24/95

TIE SKETCH

Show at least three (3) ties and monument

