

GRANT COUNTY CERTIFIED LAND CORNER



CORNER NUMBER 57

CERTIFICATE:

I, Larry L. Austin, do hereby certify that on the 26th day of October, 2000, I found evidence of the East 1/4 corner of Section 16, Town 5 North, Range 2 West, of the 4th Principal Meridian, and I re-established said corner according to the Wisconsin statutes as shown and described hereon.

Dated this 12th day of December, 2000

Larry L. Austin
Larry L. Austin S-1903

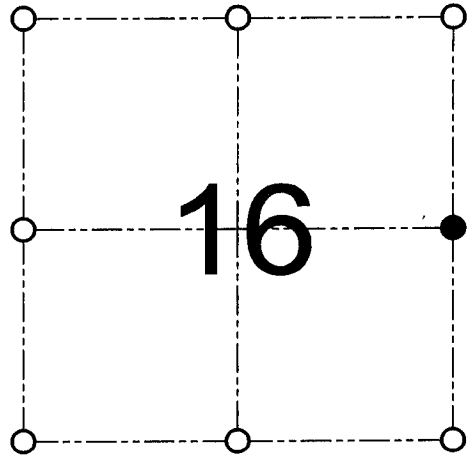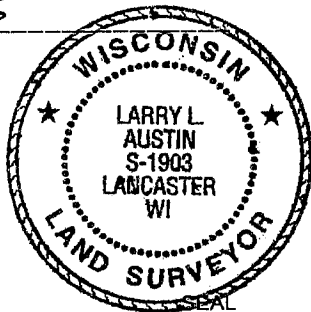

● = CORNER LOCATION

EAST 1/4 CORNER OF
SECTION 16, T 5 N R 2 W
TOWN OF LIBERTY

HISTORY OF ORIGINAL CORNER ESTABLISHMENT:

Corner was originally set in 1832 by Harvey Parke.
No other record of the corner was found.


DESCRIPTION OF CORNER EVIDENCE FOUND:

I found an occupied fence corner and accepted it's
location after an EDM & GPS traverse of the area.

DESCRIPTION OF CORNER AND WITNESS MONUMENTS, references and accessories used to perpetuate the original or re-established location of this corner

WITNESS TO THE CORNER LOCATION: TIM FAUVER & SHELBY BLINDERT & BOBBY SEDGWICK

SKETCH:

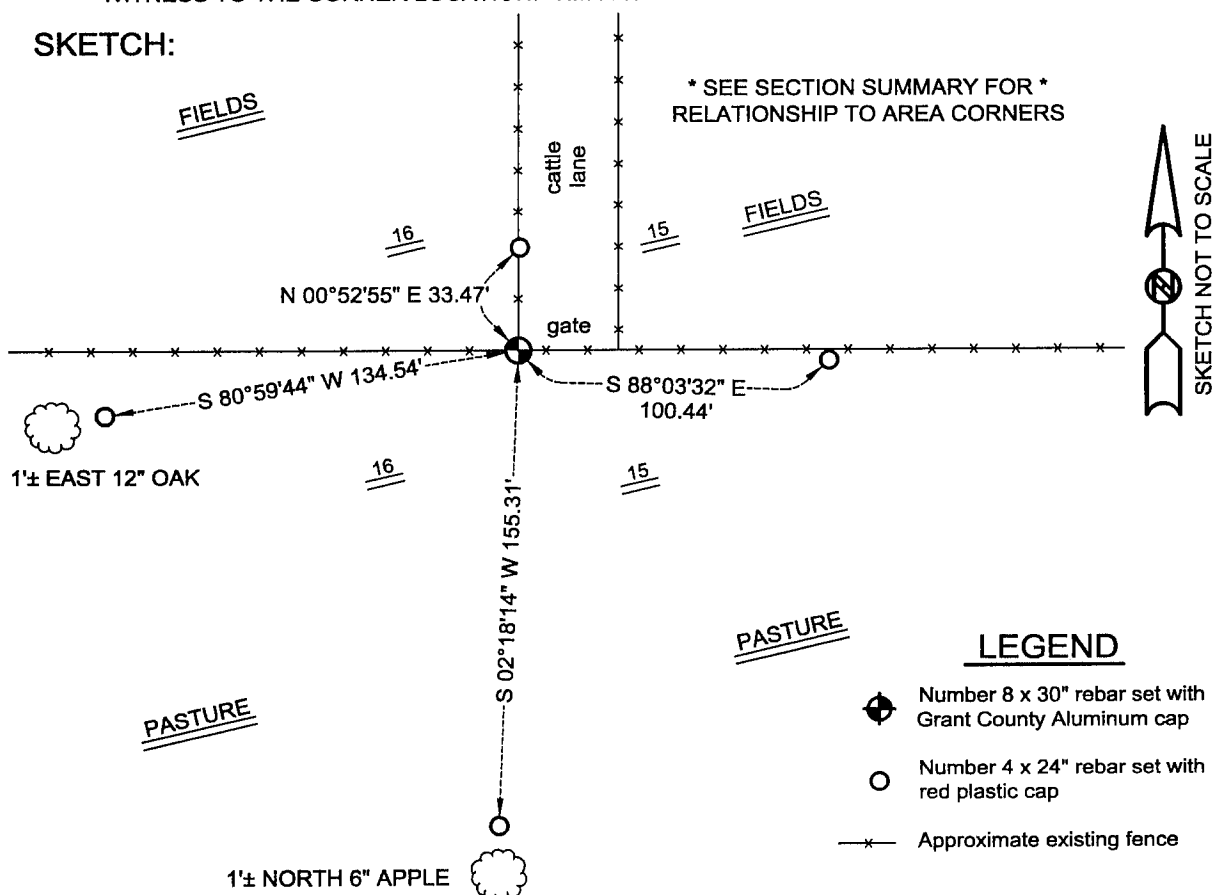

LEGEND

- Number 8 x 30" rebar set with Grant County Aluminum cap
- Number 4 x 24" rebar set with red plastic cap
- x— Approximate existing fence

AUSTIN ENGINEERING, LLC
4211 HWY 81 E, LANCASTER, WI 53813
PHONE 608-723-6363 FAX 608-723-6702

FIELDBOOK: SDR33, 20-32
G:\T5NR2W\09
C:\SC14\SWA\TIE\T5NR2W\57

DRAWN BY: SW AUSTIN
APPROVED: LL AUSTIN
CREW: BS - SB - SA - TF