

GRANT COUNTY CERTIFIED LAND CORNER


CORNER NUMBER 69

CERTIFICATE:

I, LARRY L. AUSTIN, DO HEREBY CERTIFY THAT ON 10TH DAY OF SEPTEMBER, 1999, I FOUND MONUMENTED EVIDENCE OF THE NORTHWEST CORNER SECTION 21, TOWN 5 NORTH, RANGE 2 WEST, OF THE FOURTH PRINCIPAL MERIDIAN, AND I RE-ESTABLISHED SAID CORNER ACCORDING TO THE WISCONSIN STATUTES AS SHOWN AND DESCRIBED HEREON.

DATED THIS 14TH OF SEPTEMBER, 1999

Larry L. Austin
LARRY L. AUSTIN S-1903

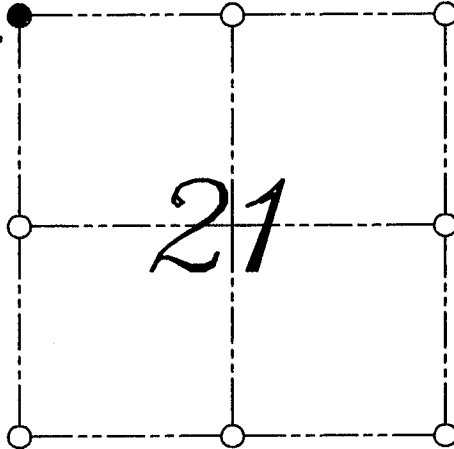

● = CORNER LOCATION
NORTHWEST CORNER OF
SECTION 21, T 5 N R 2 W
TOWN OF LIBERTY

HISTORY OF ORIGINAL CORNER ESTABLISHMENT:

CORNER WAS SET IN 1832 BY HARVEY PARKE.

DESCRIPTION OF CORNER EVIDENCE FOUND:

I FOUND A 1" IRON PIPE 8" BELOW ROAD SURFACE ONLINE WITH AN EAST-WEST FENCE AND ALSO ONLINE WITH A FENCE FROM THE SOUTH. I ACCEPTED THIS LOCATION AFTER AN E.D.M. & G.P.S. TRAVERSE OF THE AREA.

DESCRIPTION OF CORNER AND WITNESS MONUMENTS, REFERENCES AND ACCESSORIES USED TO PERPETUATE THE ORIGINAL OR RE-ESTABLISHED LOCATION OF THIS CORNER:
WITNESS TO THE CORNER LOCATION: BOBBY SEDGWICK ; SHELBY BLINDERT

SKETCH:

