


Liberty Twp

# GRANT COUNTY

## Survey Monument Record

CORNER NO. 29  
SECTION 9  
TOWN 5 North  
RANGE 2 West

TYPE OF MONUMENT Existing 2" Iron Pipe  
STATE PLANE COORDINATES: N \_\_\_\_\_  
E \_\_\_\_\_  
ELEVATION — M.S.L. DATUM: \_\_\_\_\_  
THETA ANGLE: \_\_\_\_\_  
FIELD BOOK: \_\_\_\_\_  
PAGE \_\_\_\_\_

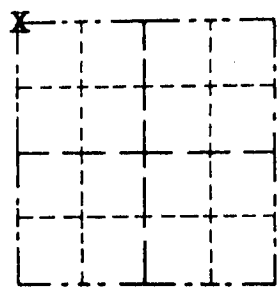

LOCATION  
(Indicated by "X")


### BASIS FOR MONUMENT LOCATION

(Use reverse side if necessary)

Show info such as: History of corner, with reference to Vol. and pg., dates, surveyor; exact description of monument replaced; if location computed, by taped or EDM traverse; landowner, remarks, etc.

SEAL:

Found 2" round, iron pipe in place as accepted from previous surveys.

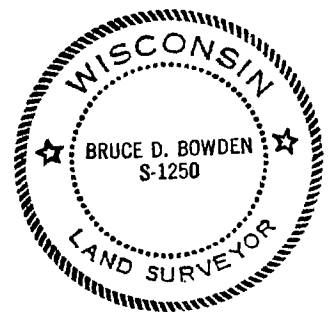

CERTIFIED CORRECT

*Bruce D. Bowden*  
Registered Land Surveyor

DATE: August 14, 1984

### TIE SKETCH

Show at least three (3) ties and monument

#### LEGEND

- Existing 2" Iron Pipe
- 1/2" x 24" round, iron, pipe set

