

RECEIVED

MAR 9 1988


U. S. PUBLIC LAND SURVEY MONUMENT RECORD

GRANT County, Wisconsin.

Basis for monument location.

Section 22, T5 N, R2 W

Last reference to the corner was the original government survey. No evidence of the corner of its accessories could be located. The area around the corner is a wooded hillside with no evidence of any occupation. I established the corner at a proportionate distance between the two adjoining corners. This distance fit well with the forty fence line to the South. Distance to the fence line measured 1326.1'.

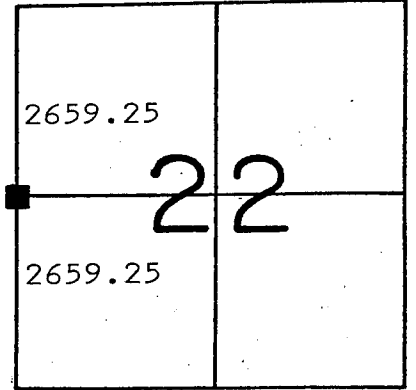

Corner Location (Indicate by - ■)

Tie sketch

TIES: 20d POLESPIKES SET IN BLAZE AT BOTTOM OF TREE

WOODED HILLSIDE

W/S 16" W. OAK

WOODED HILLSIDE

38.05'

S/S 4" CEDAR

46.75'

8.77'

N/S 9" BURR OAK

36.50'

WOODED HILLSIDE

W/S 12" BR. OAK

WOODED HILLSIDE

I, _____ Certify that the corner location shown hereon this record was determined by me or under my direction and control and that this U. S. Public Land Survey Monument Record is correct and complete to the best of my knowledge and belief.

3-8-88

Date

Matthew J. Janiak
Registered Land Surveyor

