

RECEIVED

MAR 9 1988


U. S. PUBLIC LAND SURVEY MONUMENT RECORD

GRANT County, Wisconsin.

Basis for monument location.

Last reference to the corner was the original Government survey. A stone was located at an existing fence corner standing on end. Accepted this stone as the correct corner and referenced as shown hereon. Placed a chiseled cross on the top edge of the stone.

Section 22, T5 N, R 2

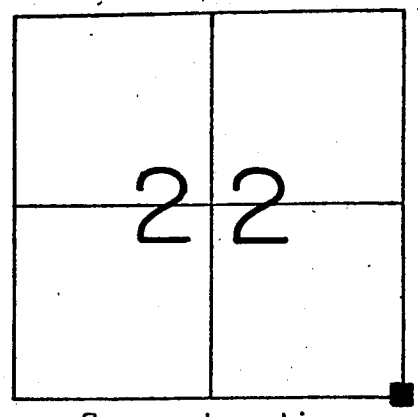

Corner Location (Indicate by - ■)

Tie sketch

TIES: 20d POLESPIKES SET IN BLAZE AT BOTTOM OF TREES

FIELD

WOODED

N/S RED OAK SAPLING

3/4" X 24" RE-BAR

SE/S 12" RED OAK

SE/S 13" MAPLE

29.51'

22.92'

26.13'

18.56'

44.75'

FIELD

FIELD

3/4" X 24" RE-BAR BURIED 10"

I, \_\_\_\_\_ Certify that the corner location shown hereon this record was determined by me or under my direction and control and that this U. S. Public Land Survey Monument Record is correct and complete to the best of my knowledge and belief.

3-8-88  
Date

*Matthew J. Janiak*  
Registered Land Surveyor



188