

GRANT COUNTY
WISCONSIN
RECEIVED

MAR 9 1988

U. S. PUBLIC LAND SURVEY MONUMENT RECORD


GRANT County, Wisconsin.

Basis for monument location.

Last reference to the corner was the original government survey. No evidence of the corner or its accessories could be located. The area near the corner is a highly eroded section. I established the above corner at a single proportionate distance between the two adjoining corners.




Section 22, T5 N, R 2

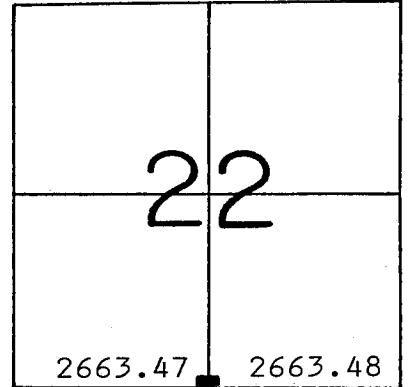

Corner Location
(Indicate by - ■)


○ - 3/4" X 24" RE - BAR

Tie sketch

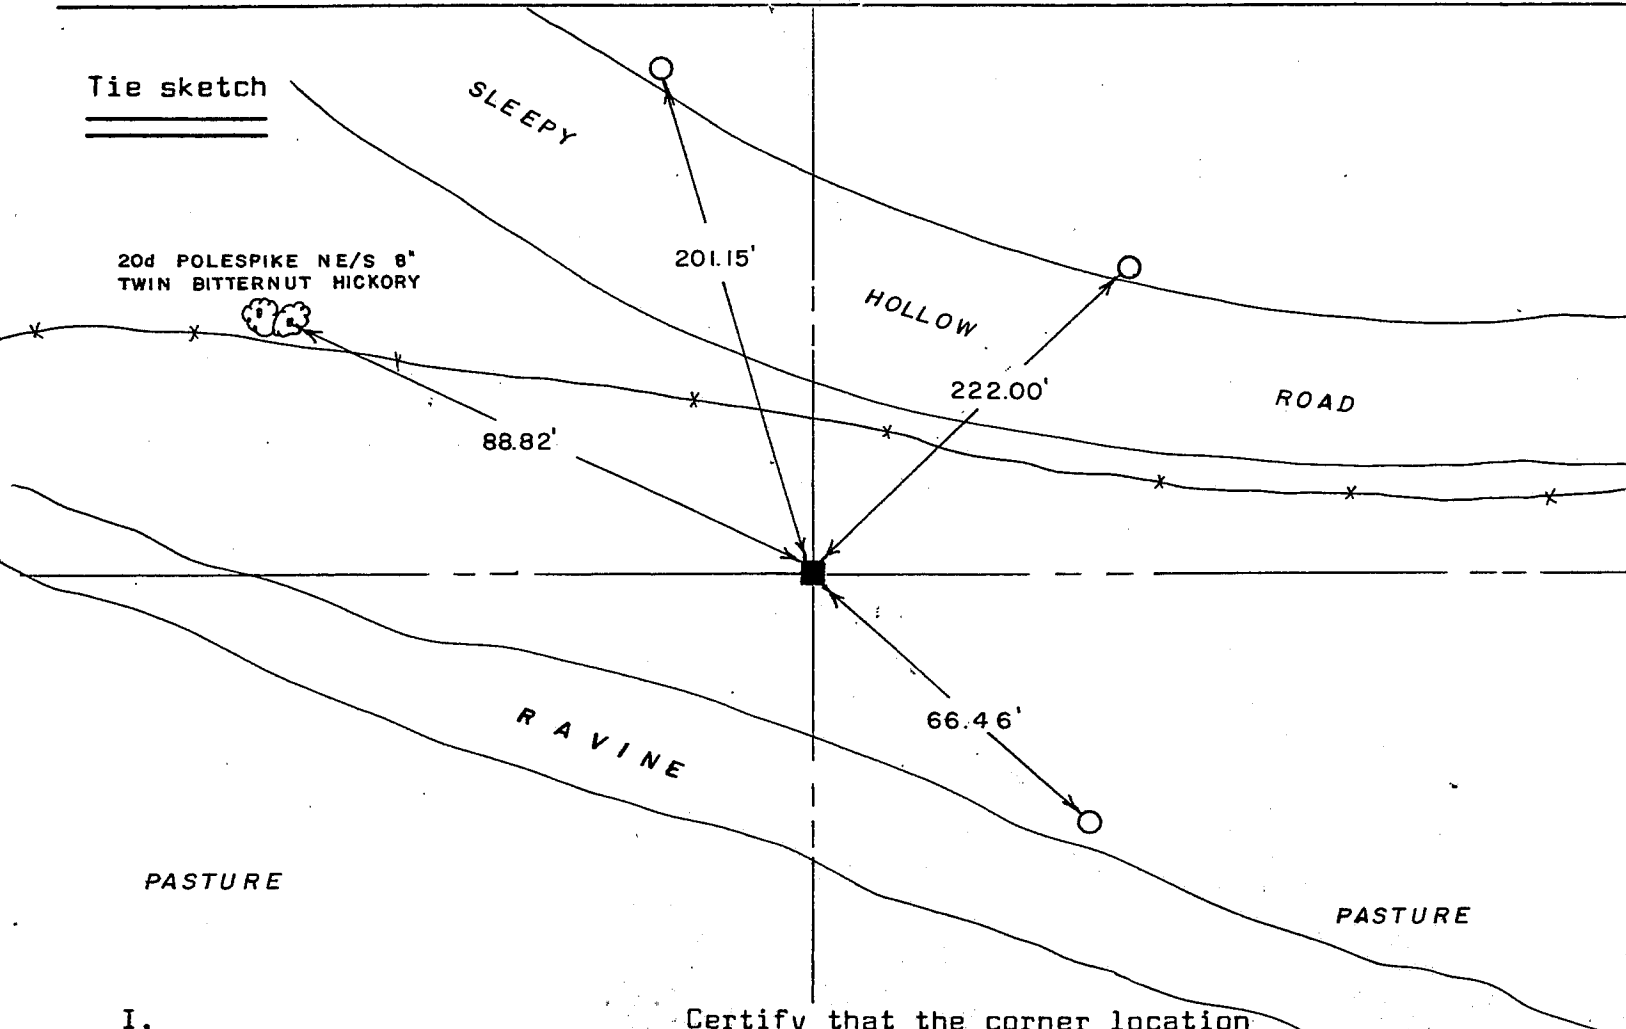

I, _____ Certify that the corner location shown hereon this record was determined by me or under my direction and control and that this U. S. Public Land Survey Monument Record is correct and complete to the best of my knowledge and belief.

3-8-88
Date

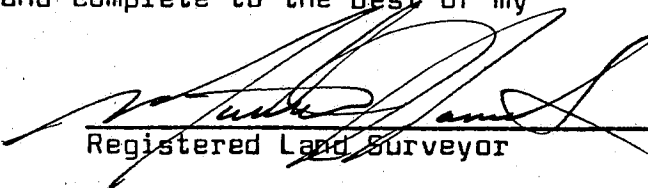
Registered Land Surveyor



136