


Survey Monument Record

TYPE OF MONUMENT 1/4 IRON BAR
ROUND

CORNER NO. 83
SECTION 24
TOWN 5N
RANGE 2W

FIELD BOOK: 96-21
PAGE 7

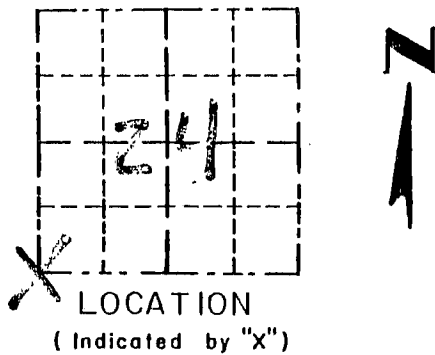


BASIS FOR MONUMENT LOCATION

(Use reverse side if necessary)

Show info such as: History of corner, with reference to Vol. and pg., dates, surveyor; exact description of monument replaced; if location computed, by taped or EDM traverse; landowner, remarks, etc.

SEAL:

CORNER SET IN 1832 BY HARVEY CLAPPE. IN 1980 B. BOWDEN SET A 1/4" IRON BAR. I ACCEPTED THIS LOCATION AFTER EDM TRAVERSE OF AREA.

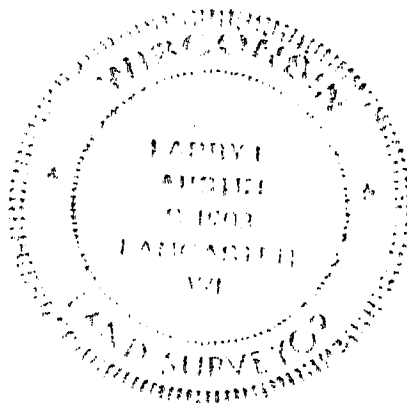

CERTIFIED CORRECT

Randy J. Rust
Registered Land Surveyor

DATE: 2/16/97

TIE SKETCH

Show at least three (3) ties and monument

LEGEND

- ⊙ 1/4" IRON BAR FND.
- 1" IRON PIPE FND.
- EXISTING FENCE C.R.P.

