


Survey Monument Record

TYPE OF MONUMENT 3/4" X 24" IRON BAR  
SET

CORNER NO. 79  
 SECTION 23  
 TOWN 5N  
 RANGE 2W

FIELD BOOK: 96-21  
 PAGE \_\_\_\_\_

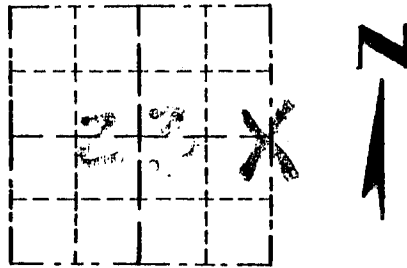

LOCATION  
 (Indicated by "X")

BASIS FOR MONUMENT LOCATION

(Use reverse side if necessary)

Show info such as: History of corner, with reference to Vol. and pg., dates, surveyor; exact description of monument replaced; if location computed, by taped or EDM traverse; landowner, remarks, etc.

SEAL:

CORNER SET IN 1832 BY HARVEY CLAPKE IN 1980 B. BOWDEN. SET A 3/4" IRON BAR. I WAS UNABLE TO LOCATE THIS. I SET A 3/4" X 24" IRON BAR AT HIS LOCATION. CORNER IS MIDWAY AND ONLINE WITH THE NE AND SE CORNERS. VERIFIED ITS LOCATION USING EDM METHODS.



CERTIFIED CORRECT

Larry L. Austin  
 Registered Land Surveyor

DATE: 2/16/97

TIE SKETCH

Show at least three (3) ties and monument

LEGEND

- ⊕ 3/4" X 24" IRON BAR SET
- 3/4" X 24" IRON BAR SET USED AS CORNERS OF L.L. AUSTIN SURVEY PLAT.

