


Survey Monument Record

TYPE OF MONUMENT 3/4" x 24" IRON BAR
SET

CORNER NO. 82
 SECTION 24
 TOWN 5 N
 RANGE 2 W

FIELD BOOK: 96-21
 PAGE (10)

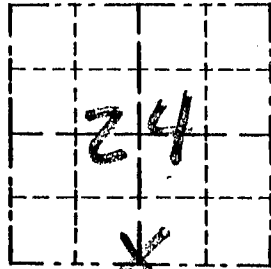


BASIS FOR MONUMENT LOCATION

(Use reverse side if necessary)

Show info such as: History of corner, with reference to Vol. and pg., dates, surveyor; exact description of monument replaced; if location computed, by taped or EDM traverse; landowner, remarks, etc.

SEAL:

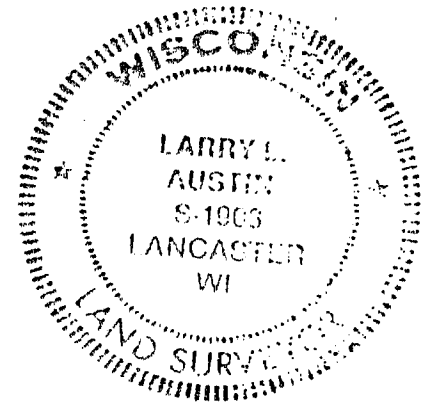

CORNER SET IN 1832 BY HARVEY CLARKE, JOEL BARBER LOCATED THE CORNER AND SET BEARING TREES FOR THE CORNER. THE BEARING TREES WERE UNRECOVERABLE. I SET THE CORNER MIDWAY AND ONLINE BETWEEN THE SOUTHWEST AND THE SOUTHEAST CORNERS. VERIFIED ITS LOCATION USING EDM METHODS.

CERTIFIED CORRECT

Larry L. Austin
 Registered Land Surveyor
 DATE: 2/16/97

TIE SKETCH

Show at least three (3) ties and monument

LEGEND

- ⊕ 3/4" x 24" IRON BAR SET
- 1/2" x 15" IRON BAR SET
- - - EXISTING FENCE

