

U.S. PUBLIC LAND SURVEY MONUMENT RECORD – GRANT COUNTY, WI



Section 19, Town 5 North Range 1 West, Town of Clifton

CERTIFICATE

I, Larry L. Austin, do hereby certify that the corner location on this record was determined by me and/or under my direct supervision and that this U.S. public land survey monument record is correct and complete to the best of my knowledge and belief.

Dated this 31st day of August, 2005

Larry L. Austin
Larry L. Austin S-1903

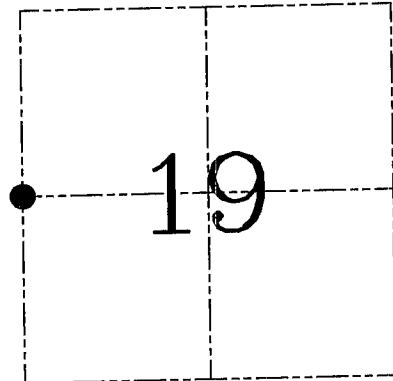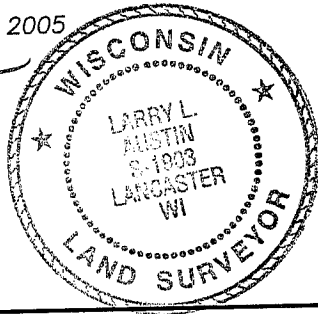

● = CORNER LOCATION

HISTORY OF CORNER ESTABLISHMENT


Corner was never originally set.
No other record of the corner was found.

DESCRIPTION OF CORNER EVIDENCE FOUND

I reset the corner at the proportioned offset and on-line between the East 1/4 and Northeast Corner of Section 24, T5N R2W. Verified this location using EDM & GPS methods.

DESCRIPTION OF CORNER AND WITNESS MONUMENTS, references and accessories used to perpetuate the original or re-established location of this corner. Witnesses to corner location Bobby Sedgwick & Brad Digman & Shane Austin

SKETCH:

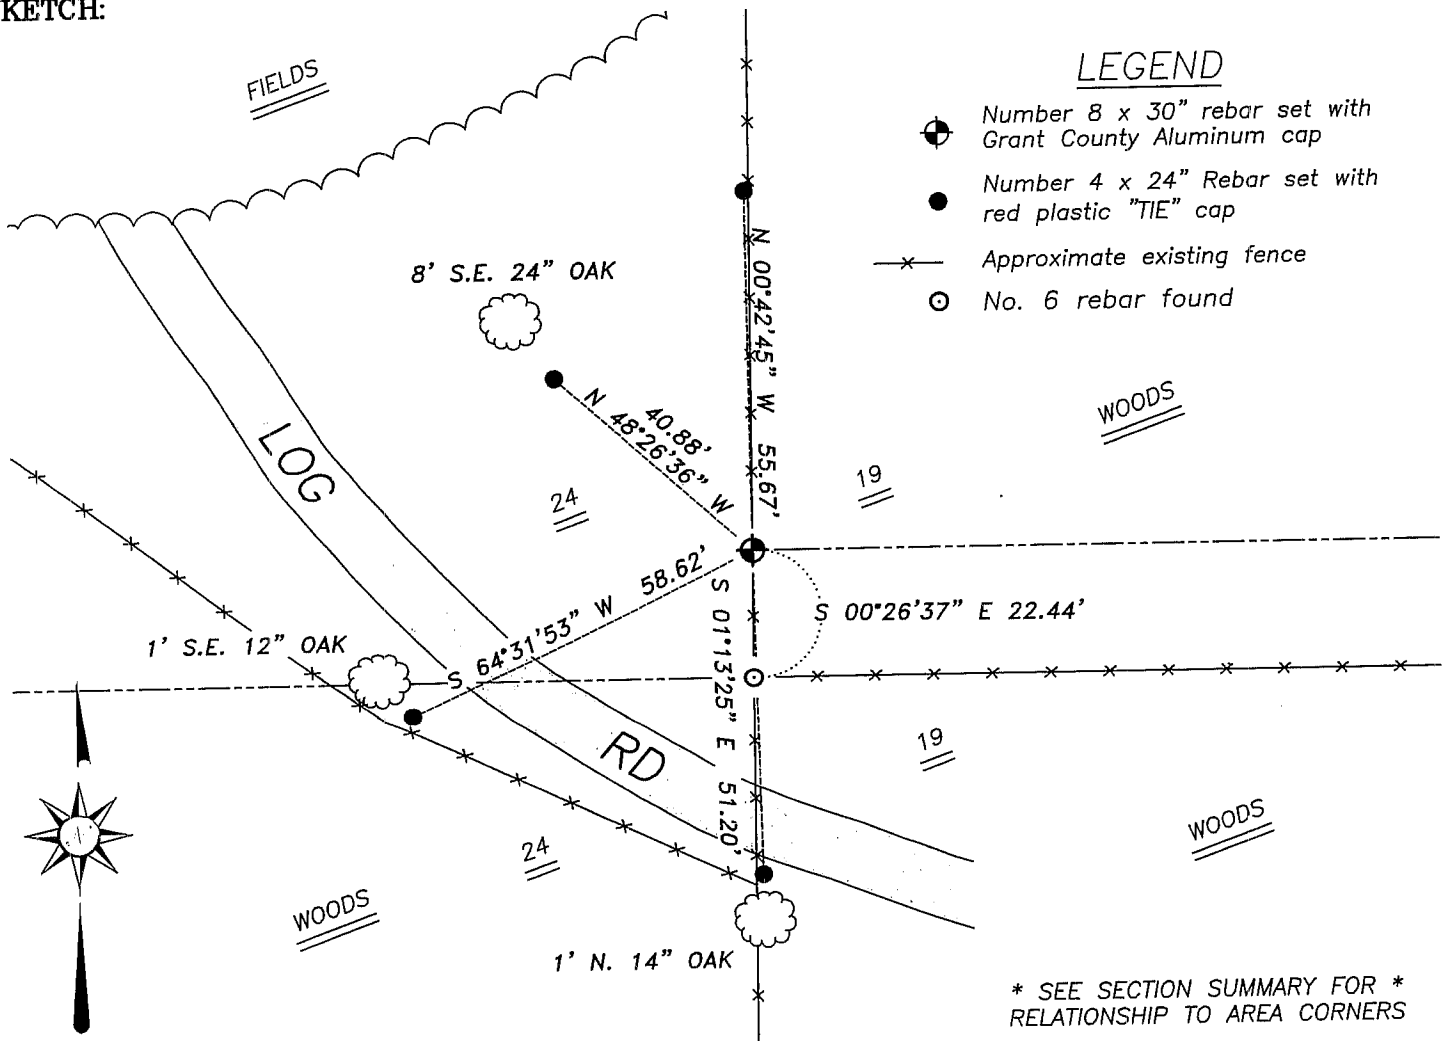

SKETCH NOT TO SCALE



Austin Engineering LLC

4211 HWY 81 E, LANCASTER, WI 53813
PHONE 608-723-6363 FAX 608-723-6702

JOB NUMBER 05S150
FIELDBOOK: TDSR, 2516
G:\T5NR1W\32
H:\TIE\T5NR1W\74


DRAWN BY: ML DIGMAN
APPROVED: LL AUSTIN

Survey Monument Record

TYPE OF MONUMENT 3/4" X 24" IRON BAR SET

CORNER NO. 80
 SECTION 24
 TOWN 5N
 RANGE 2W

FIELD BOOK: 96-21
 PAGE (6)

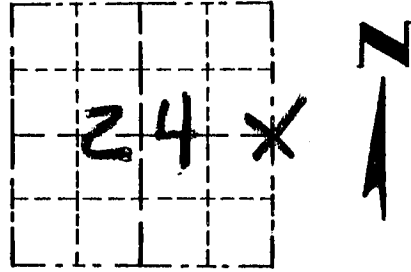

LOCATION
 (Indicated by "X")

BASIS FOR MONUMENT LOCATION

(Use reverse side if necessary)

Show info such as: History of corner, with reference to Vol. and pg., dates, surveyor; exact description of monument replaced; if location computed, by taped or EDM traverse; landowner, remarks, etc.

SEAL:

CORNER SET IN 1832 BY SIBLEY.

NO RECORD OF CORNER FOUND

SINCE ORIGINAL SURVEY. CORNER


SET AT OCCUPIED FENCE CORNER.

THIS OCCUPIED FENCE CORNER FITS

WELL WITH CORNER 1/2 MILE NORTH,

SOUTH. VERIFIED IT LOCATION USING

EDM TRAVERSE OF AREA.

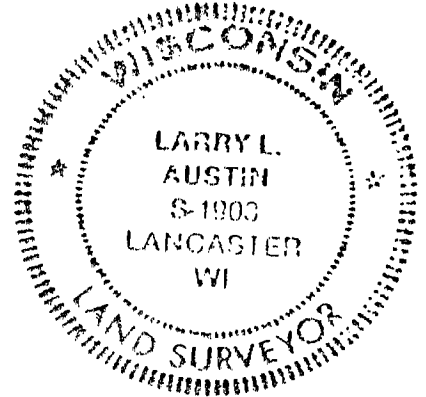

CERTIFIED CORRECT

Larry L. Austin
 Registered Land Surveyor

DATE: 2/16/97

TIE SKETCH

Show at least three (3) ties and monument

LEGEND

- 3/4" X 24" IRON BAR SET
- 1/2" X 15" IRON BAR SET
- ✕ EXISTING FENCE

