

GRANT COUNTY

Survey Monument Record

TYPE OF MONUMENT 3/4" X 24" IRON BAR SET

STATE PLANE COORDINATES: N _____
E _____

ELEVATION - M.S.L. DATUM: _____

THETA ANGLE: _____

FIELD BOOK: 96-08


PAGE _____

CORNER NO. 102

SECTION 36

TOWN 5N

RANGE 2W

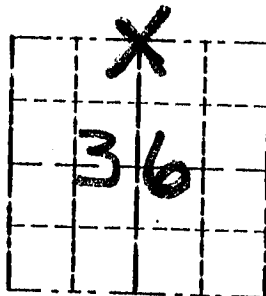

LOCATION
(Indicated by "X")




BASIS FOR MONUMENT LOCATION

(Use reverse side if necessary)

CORNER SET IN 1832 BY HARVEY CLARK. NO RECORD FOUND SINCE ORIGINAL SURVEY. CORNER SET IN FENCE EAST/WEST FOR NORTHING. FOR EASTING CORNER WAS SET EQUIDISTANT BETWEEN NORTHWEST AND NORTHEAST CORNERS. VERIFIED ITS LOCATION USING EDM METHODS.

SEAL:

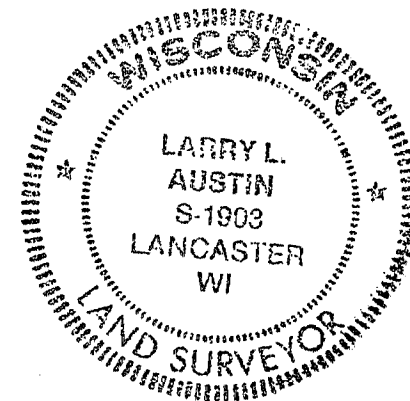


CERTIFIED CORRECT

Larry L. Austin
Registered Land Surveyor

DATE: 10-1-96

TIE SKETCH

Show at least three (3) ties and monument

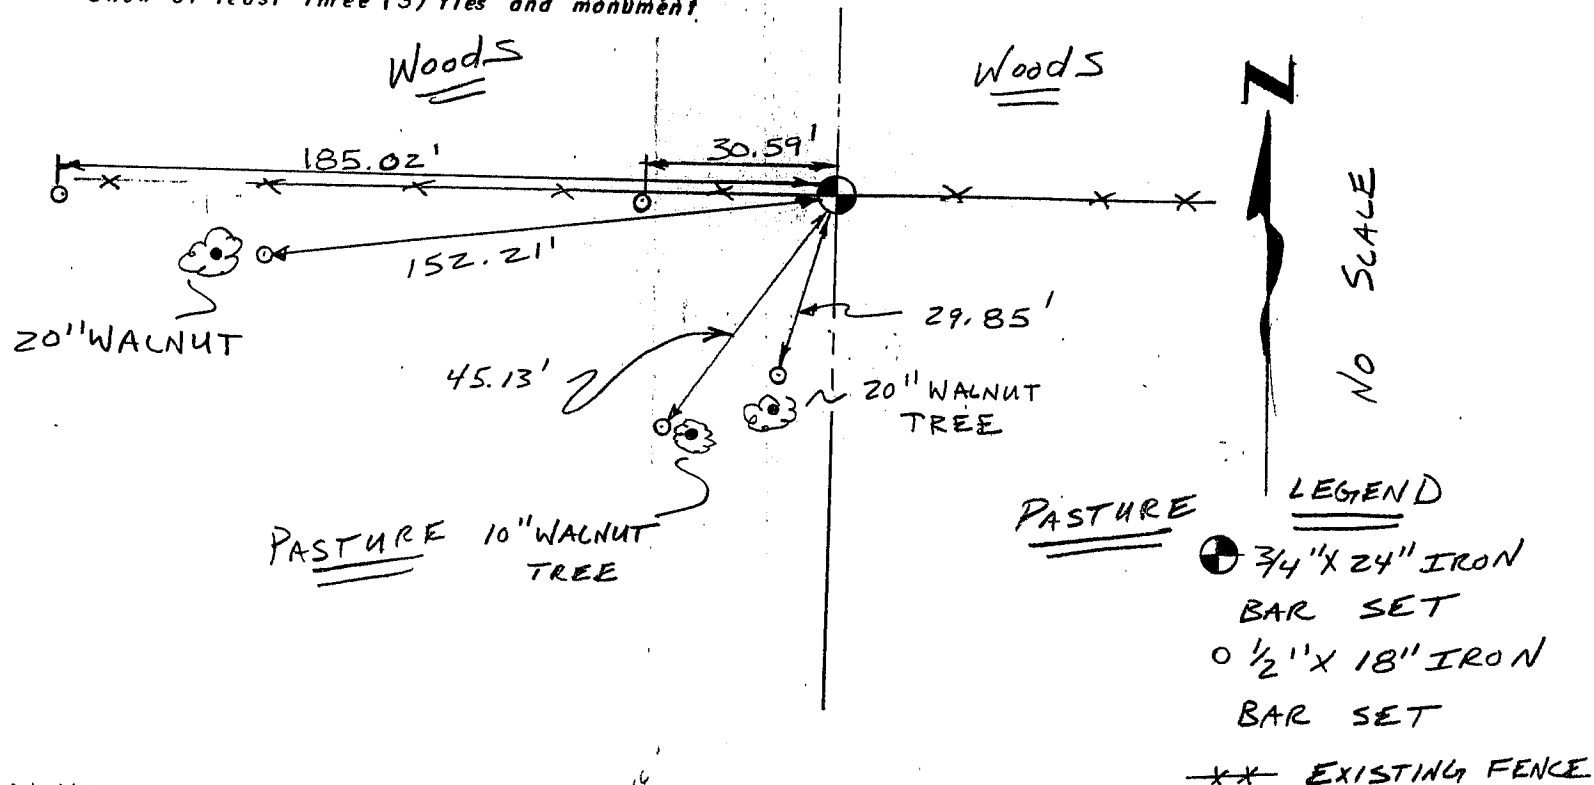

- LEGEND
- 3/4" X 24" IRON BAR SET
 - 1/2" X 18" IRON BAR SET
 - EXISTING FENCE