


GRANT COUNTY

Survey Monument Record

TYPE OF MONUMENT 3/4" x 24" IRON BAR SET
 STATE PLANE COORDINATES: N _____
 E _____
 ELEVATION — M.S.L. DATUM: _____
 THETA ANGLE: _____
 FIELD BOOK: 96-08
 PAGE _____

CORNER NO. 103
 SECTION 36
 TOWN 5N
 RANGE 2W

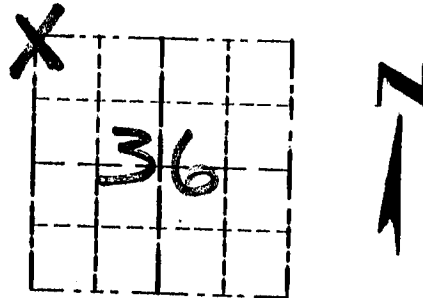


LOCATION
(Indicated by "X")

BASIS FOR MONUMENT LOCATION

(Use reverse side if necessary)

CORNER SET IN 1832 BY HARVEY CLARK. NO RECORD FOUND SINCE ORIGINAL SURVEY. CORNER SET AT A OCCUPATIONAL FENCE CORNER. CORNER VERIFIED USING EDM METHODS.

SEAL:

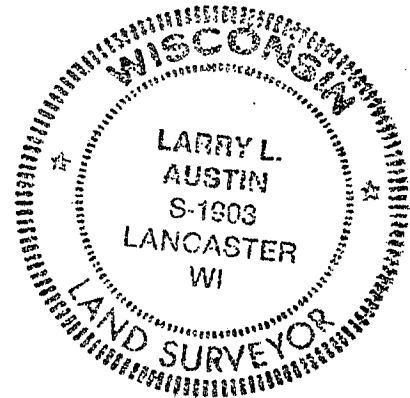

CERTIFIED CORRECT

Larry L. Austin
 Registered Land Surveyor
 DATE: 10-1-96

TIE SKETCH

Show at least three (3) ties and monument

LEGEND

- ⊕ 3/4" x 24" IRON BAR SET
- 1/2" x 18" IRON BAR SET
- x-x- EXISTING FENCE

