

# GRANT COUNTY CERTIFIED LAND CORNER


CORNER NUMBER 104

**CERTIFICATE:**

I, Larry L. Austin, do hereby certify that on the 8th day of August, 2000, I found evidence of the North 1/4 corner of Section 35, Town 5 North, Range 2 West, of the 4th Principal Meridian, and I re-established said corner according to the Wisconsin statutes as shown and described hereon.

Dated this 3rd day of November, 2000

*Larry L. Austin*  
Larry L. Austin S-1903

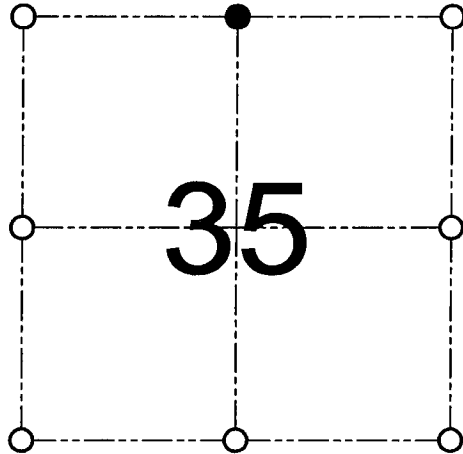

● = CORNER LOCATION

NORTH 1/4 CORNER OF  
SECTION 35, T 5 N R 2 W  
TOWN OF LIBERTY

**HISTORY OF ORIGINAL CORNER ESTABLISHMENT:**

Corner was originally set in 1832 by Harvey Parke.  
No other record of the corner was found.

**DESCRIPTION OF CORNER EVIDENCE FOUND:**

I found an occupied location and accepted it after  
an E.D.M. & G.P.S. traverse of the area.

**DESCRIPTION OF CORNER AND WITNESS MONUMENTS, references and accessories used to perpetuate the original or re-established location of this corner**

WITNESS TO THE CORNER LOCATION: SHELBY BLINDERT & JERRY SPEILMAN

**SKETCH:**

