

GRANT COUNTY

Survey Monument Record

TYPE OF MONUMENT 3/4" X 24" IRON BAR SET

STATE PLANE COORDINATES: N _____
E _____

ELEVATION — M.S.L. DATUM: _____

THETA ANGLE: _____

FIELD BOOK: 96-08


PAGE _____

CORNER NO. 119

SECTION 36

TOWN 5N

RANGE 2W

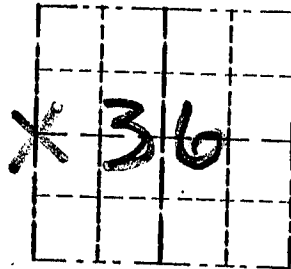


LOCATION
(Indicated by "X")

BASIS FOR MONUMENT LOCATION

(Use reverse side if necessary)

CORNER SET IN 1832 BY HARVEY CLARK. NO RECORD FOUND SINCE ORIGINAL SURVEY. CORNER SET AT A OCCUPATIONAL FENCE CORNER. CORNER VERIFIED USING EDM METHODS.

SEAL:

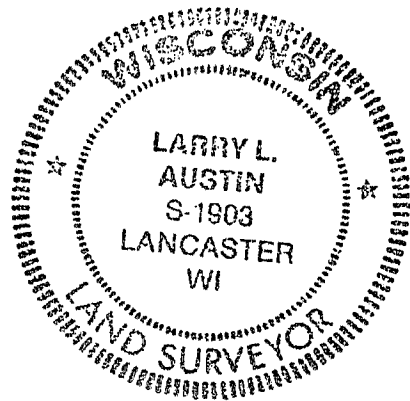

CERTIFIED CORRECT

Larry L. Austin
Registered Land Surveyor

DATE: 10-1-96

TIE SKETCH

Show at least three (3) ties and monument.

LEGEND

- ⊕ 3/4" X 24" IRON BAR SET
- 1/2" X 18" IRON BAR SET
- XX EXISTING FENCE

