

# GRANT COUNTY

## Survey Monument Record

TYPE OF MONUMENT 3/4" X 24" IRON BAR SET

STATE PLANE COORDINATES: N \_\_\_\_\_  
E \_\_\_\_\_

ELEVATION — M.S.L. DATUM: \_\_\_\_\_

THETA ANGLE: \_\_\_\_\_

FIELD BOOK: 96-08


PAGE \_\_\_\_\_

CORNER NO. 122

SECTION 36

TOWN 5N

RANGE 2W

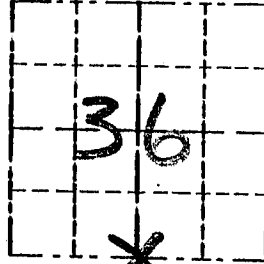


LOCATION  
(Indicated by "X")

### BASIS FOR MONUMENT LOCATION

(Use reverse side if necessary)

CORNER SET IN 1832 BY  
SIBLEY. NO RECORD FOUND  
SINCE ORIGINAL SURVEY. SEAL:  
CORNER SET AT A  
OCCUPATIONAL FENCE CORNER,  
CORNER VERIFIED USING  
EDM METHODS.

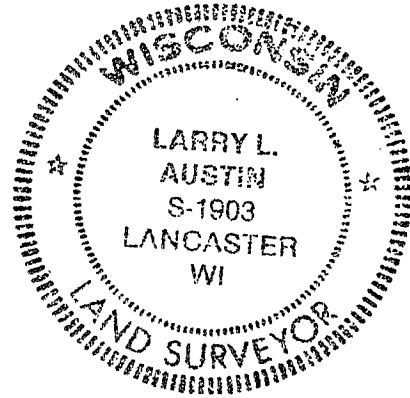

CERTIFIED CORRECT

*Larry L. Austin*  
Registered Land Surveyor

DATE: 10-1-96

### TIE SKETCH

Show at least three (3) ties and monument

#### LEGEND

⊕ 3/4" X 24" IRON BAR SET

○ 1/2" X 18" IRON BAR SET

\*\*\* EXISTING FENCE

