


Survey Monument Record

TYPE OF MONUMENT 3/4" X 24" IRON BAR SET.

CORNER NO. 46
 SECTION 15
 TOWN SN
 RANGE 3W

FIELD BOOK: 96-17
 PAGE (5)

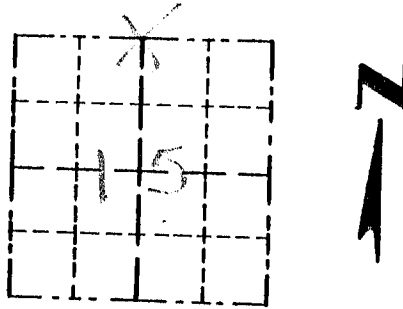

LOCATION
 (Indicated by "X")


BASIS FOR MONUMENT LOCATION

(Use reverse side if necessary)

Show info such as: History of corner, with reference to Vol. and pg, dates, surveyor; exact description of monument replaced; if location computed, by taped or EDM traverse; landowner, remarks, etc.

CORNER SET BY HARVEY CLARK. NO RECORD OF CORNER FOUND SINCE ORIGINAL SURVEYS; CORNER SET ONLINE WITH FENCE NORTH/SOUTH NORTH OF CORNER FOR EASTING. NORTHING SET BY EXISTING FENCE EAST/WEST, WEST OF CORNER. VERIFIED ITS LOCATION USING EDM METHODS.

SEAL:

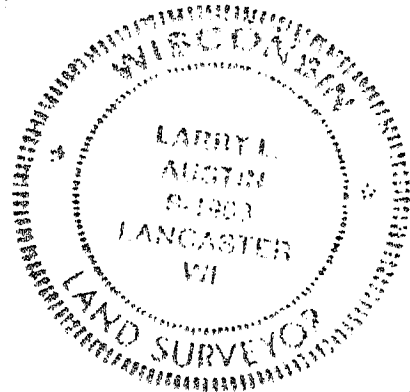

CERTIFIED CORRECT

Larry L. Austin
 Registered Land Surveyor

DATE: 7/30/97

TIE SKETCH

Show at least three (3) ties and monument

LEGEND

- ⊕ 3/4" X 24" IRON BAR SET
- 1/2" X 15" IRON BAR SET
- *X EXISTING FENCE

