

North Lancaster Township

US. PUBLIC LAND SURVEY MONUMENT RECORD

CORNER DESCRIPTION: N¹/₄ CORNER, SECTION 24, T 5 N, R 3 W

STATE PLANE COORDINATES: N _____, E _____

THETA ANGLE: _____


HORIZONTAL DATUM: WISCONSIN STATE PLANE COORDINATE SYSTEM, SOUTH ZONE

EVIDENCE: No Government Monument on Record. Long-standing fence in excellent condition, to North Gravel Lane to South.


MONUMENT: FOUND ☐, PLACED ☒
METHOD OF RESTORATION(RE-ESTABLISHMENT):
☐ ACCEPTED EXISTING MONUMENT
N ☒, E ☒ ACCEPTED OCCUPATION
N ☐, E ☐ LOST CORNER PROPORTIONATE METHODS
DATE CORNER SET: 2-19-83

LEGEND

- ▲ SET #6 REBAR, 1.13 LBS PER LINEAL FT. MIN. WT.
- SET 1" X 24" IRON PIPE, 1.13 LBS PER LINEAL FT. MIN. WT.
- SET 2" X 30" IRON PIPE, 3.65 LBS. PER LINEAL FT. MIN. WT.
- FOUND 1" IRON PIPE
- FOUND 2" IRON PIPE
- FOUND R/R SPIKE
- SET R/R SPIKE
- GOVERNMENT CORNER
- EXISTING FENCE

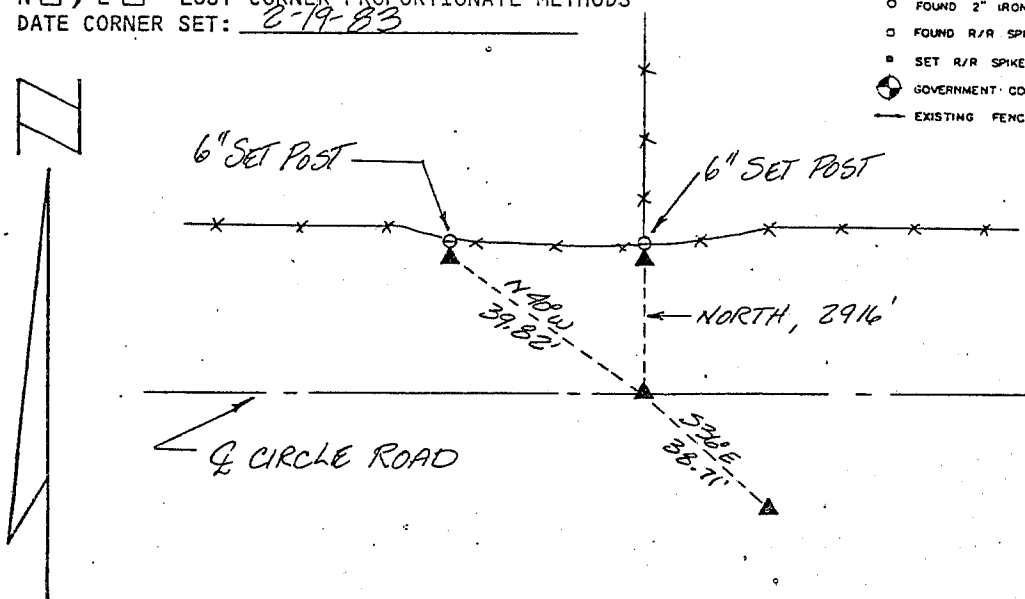

SECTION 24
T 5 N, R 3 W

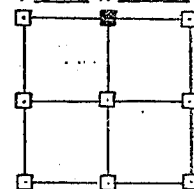

NOT TO SCALE THIS CONFORMS TO WISCONSIN ADMINISTRATIVE CODE A-E 5.02


SURVEYOR'S AFFIDAVIT:

STATE OF WISCONSIN)
GRANT COUNTY) SS

I hereby certify that I, DOUGLAS J. MALLIET, have complied with the Wisconsin State Statutes, Statutes of the United States, and the rules and regulations made by the Secretary of the Interior in the location of the corner shown above.

DATE OF SURVEY: 3-5-83

Douglas J. Malliet
REGISTERED LAND SURVEYOR
1246

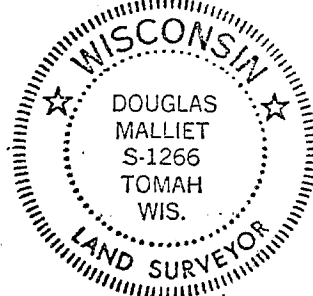

D. F. BURBACH MUNICIPAL & CIVIL ENGINEERS

410 NORTH SECOND STREET • PLATTEVILLE, WISCONSIN 53818 • (608) 348-3262

MAY 24 1983

p 62