


Survey Monument Record

TYPE OF MONUMENT 3/4" X 24" IRON BAR  
SET

CORNER NO. 65  
 SECTION 15  
 TOWN 5N  
 RANGE 3W

FIELD BOOK: 96-17  
 PAGE (5)

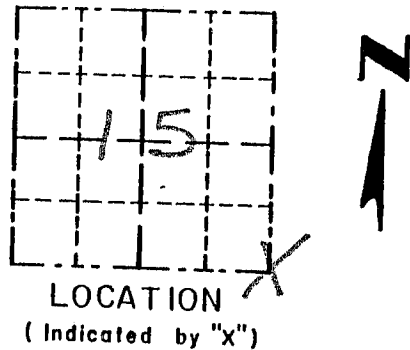

BASIS FOR MONUMENT LOCATION

(Use reverse side if necessary)

Show info such as: History of corner, with reference to Vol. and pg., dates, surveyor; exact description of monument replaced; if location computed, by taped or EDM traverse; landowner, remarks, etc.

SEAL:



CORNER SET BY HARVEY CLARK. I SET A IRON PIPE AT A OCCUPIED FENCE CORNER. AFTER FURTHER TRAVERSE OF AREA NORTH / SOUTH / EAST I FOUND THE FENCE CORNER NOT TO BE IN THE RIGHT LOCATION. A TREE LINE AND EXISTING FENCE LINE TO THE NORTH WAS USED TO SET THE EASTING OF IT. EXISTING FENCE EAST / WEST WAS USED FOR NORTHING. VERIFIED ITS LOCATION USING EDM METHODS.

CERTIFIED CORRECT

*Larry L. Austin*  
 Registered Land Surveyor

DATE: 8-1-97

TIE SKETCH

Show at least three (3) ties and monument

LEGEND

- 3/4" X 24" IRON BAR SET
- IRON PIPE FOUND
- 1/2" X 15" IRON BAR SET
- EXISTING FENCE
- FIELDS

