


Survey Monument Record

TYPE OF MONUMENT GRANT COUNTY
Alum. Mon. Found.

CORNER NO. 69
 SECTION 21
 TOWN 5N
 RANGE 3W

FIELD BOOK: 96-17
 PAGE (5)

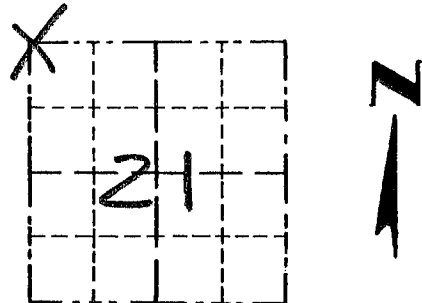

LOCATION
 (Indicated by "X")


BASIS FOR MONUMENT LOCATION

(Use reverse side if necessary)

Show info such as: History of corner, with reference to Vol. and pg., dates, surveyor; exact description of monument replaced; if location computed, by taped or EDM traverse; landowner, remarks, etc.

SEAL:

CORNER SET BY HARVEY CLARK, IN 1987. I SET AN ALUM. MON AT AN OCCUPIED FENCE CORNER. I ACCEPTED THIS LOCATION AFTER A EDM TRAVERSE OF AREA.

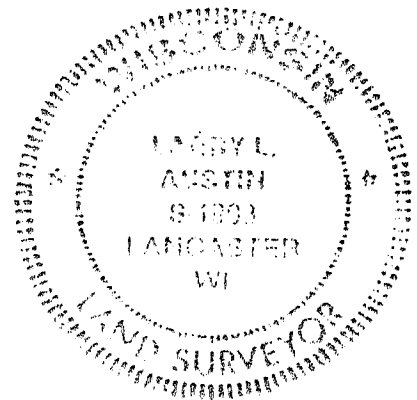

CERTIFIED CORRECT

[Signature]
 Registered Land Surveyor

DATE: 7-30-97

TIE SKETCH

Show at least three (3) ties and monument

LEGEND

- ⊕ GRANT COUNTY ALUM MON. FND.
- 1/2" x 15" IRON BAR SET
- ✕✕ EXISTING FENCE
- Woods

