

# GRANT COUNTY

## Survey Monument Record

TYPE OF MONUMENT ALUMINUM MONUMENT  
 STATE PLANE COORDINATES: N \_\_\_\_\_  
 E \_\_\_\_\_  
 ELEVATION — M.S.L. DATUM: \_\_\_\_\_  
 THETA ANGLE: \_\_\_\_\_  
 FIELD BOOK: 94-15  
 PAGE 21

CORNER NO. 70  
 SECTION 17  
 TOWN 5N  
 RANGE 3W  
S 1/4 COR



LOCATION  
 (Indicated by "•")


### BASIS FOR MONUMENT LOCATION

(Use reverse side if necessary)

Show info such as: History of corner, with reference to Vol. and pg., dates, surveyor; exact description of monument replaced; if location computed, by taped or EDM traverse; landowner, remarks, etc.

SEAL:

NO RECORD FOUND OF COR.  
SINCE ORIG. SURVEYS; MONU-  
MENT SET AT OCCUPIED LOCATION  
& VERIFIED BY EDM TRAVERSE OF  
THE AREA.

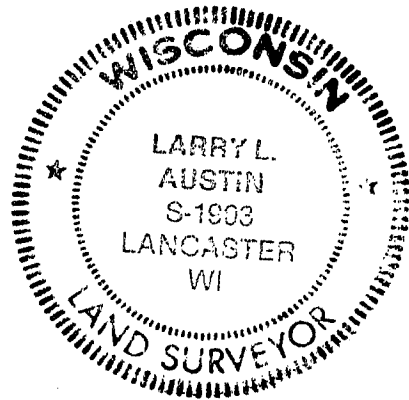

CERTIFIED CORRECT

Larry L. Austin  
 Registered Land Surveyor


DATE: 8/30/94

### TIE SKETCH

Show at least three (3) ties and monument

### LEGEND

- ALUMINUM MONUMENT
- 1" x 12" IRON PIPE SET
- FENCE EXISTING

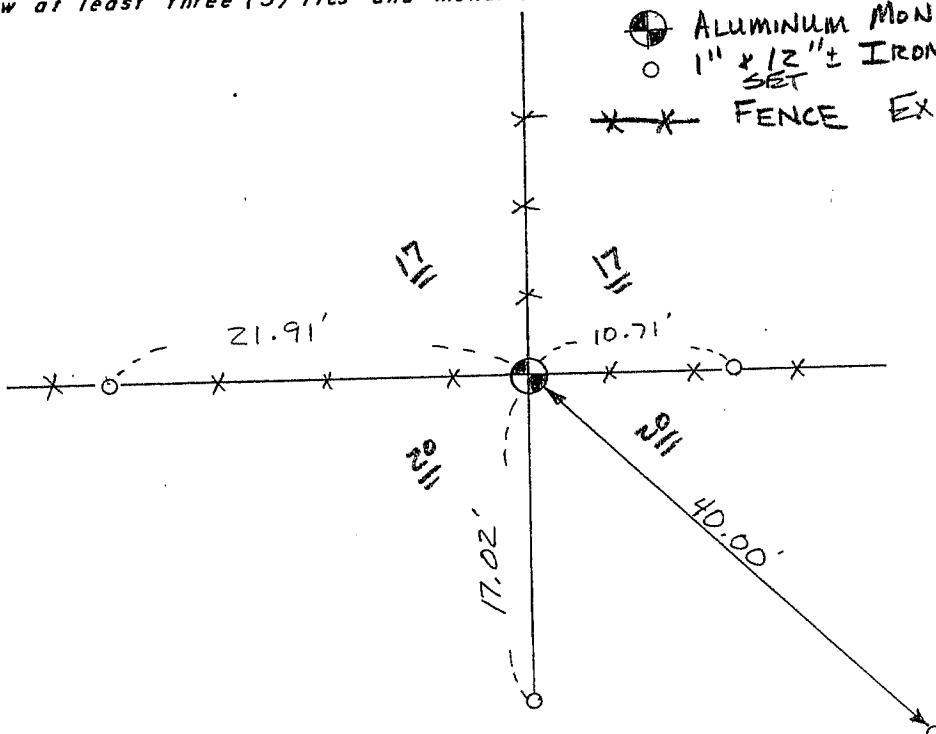

NO SCALE