


GRANT COUNTY

Survey Monument Record

TYPE OF MONUMENT COUNTY MONUMENT
 STATE PLANE COORDINATES: N _____
 E _____
 ELEVATION — M.S.L. DATUM: _____
 THETA ANGLE: _____
 FIELD BOOK: 9505
 PAGE 17

CORNER NO. 72
 SECTION 18
 TOWN 5 N
 RANGE 3 W
S 1/4 Cor

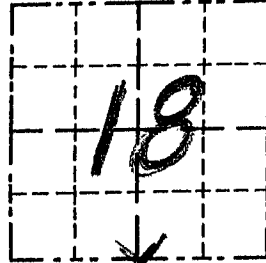

LOCATION
 (Indicated by "X")


BASIS FOR MONUMENT LOCATION

(Use reverse side if necessary)

Show info such as: History of corner, with reference to Vol. and pg., dates, surveyor; exact description of monument replaced; if location computed, by taped or EDM traverse; landowner, remarks, etc.

SEAL:

NO RECORD FOUND SINCE ORIGINAL SURVEY IN 1833 BY PARKE. CORNER WAS SET AT OCCUPIED FENCE CORNER AND VERIFIED BY EDM TRAVERSE OF THE AREA

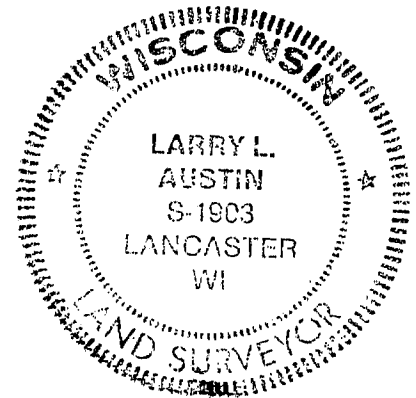

CERTIFIED CORRECT

Larry L. Austin
 Registered Land Surveyor

DATE: 9/15/95


TIE SKETCH

Show at least three (3) ties and monument

LEGEND

- ⊕ GRANT COUNTY ALUMINUM MON. SET
- 1" x 12" IRON PIPE SET
- 3/4" x 12" IRON BAR SET

* * * EXISTING FENCE

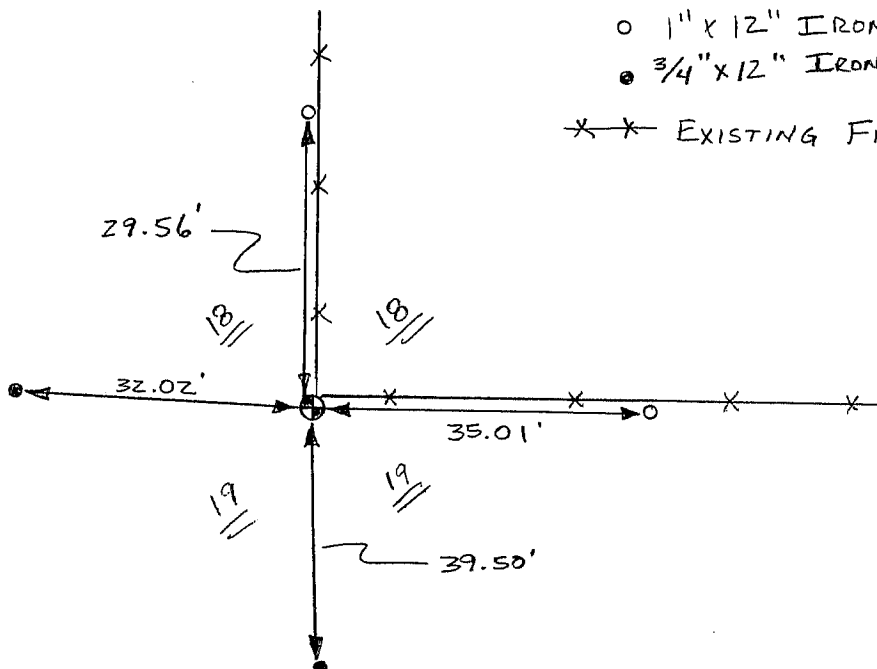

NO SCALE