

GRANT COUNTY

REC'D JAN 29 1996

Survey Monument Record

TYPE OF MONUMENT 3/4" x 24" IRON BAR SET W/CAP

STATE PLANE COORDINATES: N _____
E _____


ELEVATION — M.S.L. DATUM: _____

THETA ANGLE: _____

FIELD BOOK: 95-13

PAGE (31)

CORNER NO. 92
SECTION 30
TOWN 5N
RANGE 3W1

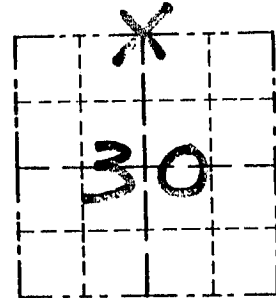

LOCATION
(Indicated by "X")

BASIS FOR MONUMENT LOCATION

(Use reverse side if necessary)

A 3/4" x 24" IRON BAR WITH ALUMINUM CAP SET AT PROJECTION OF FENCE NORTH AND PROJECTION OF FENCE REMNANTS TO WEST, AFTER VERIFICATION BY EDM TRAVERSE OF THE AREA.

SEAL:


CERTIFIED CORRECT

Larry L. Cant
Registered Land Surveyor

DATE: 1/8/96

TIE SKETCH

Show at least three (3) ties and monument

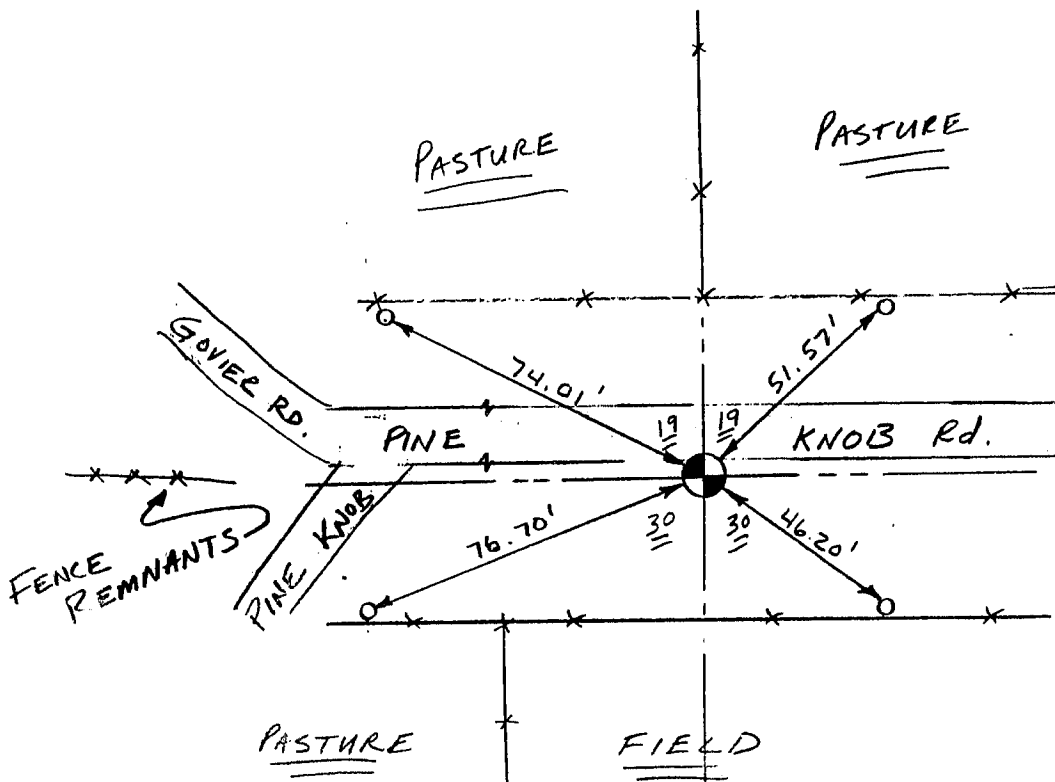

LEGEND

- 3/4" x 24" IBS W/CAP
- 1" x 12" IRON PIPE SET AS TIES
- EXISTING FENCE