


Survey Monument Record

TYPE OF MONUMENT 3/4" X 24" IRON
BAR SET

CORNER NO. ~~77~~ 77
SECTION 22
TOWN 5N
RANGE 3W

FIELD BOOK: 96-~~118~~ 17
PAGE (5)

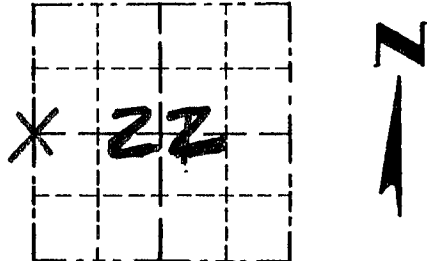


BASIS FOR MONUMENT LOCATION

(Use reverse side if necessary)

Show info such as: History of corner, with reference to Vol. and pg., dates, surveyor; exact description of monument replaced; if location computed, by taped or EDM traverse; landowner, remarks, etc.

SEAL:

CORNER SET BY HARVEY, CLARK. NO RECORD OF CORNER FOUND SINCE ORIGINAL SURVEY; CORNER WAS SET AT A OCCUPIED FENCE CORNER. VERIFIED ITS LOCATION USING EDM METHODS.

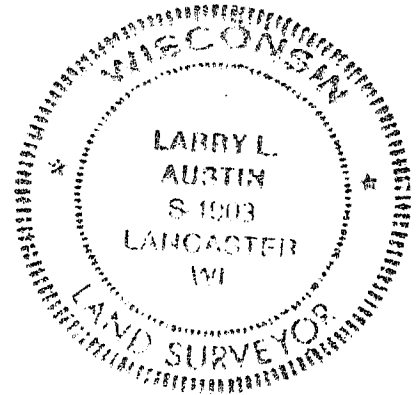

CERTIFIED CORRECT

Larry L. Austin
Registered Land Surveyor

DATE: 7-30-97

TIE SKETCH

Show at least three (3) ties and monument

LEGEND

PASTURE

⊕ 3/4 X 24" IRON BAR SET

○ 1/2" X 18" IRON BAR SET

* * * EXISTING FENCE

