

Survey Monument Record

TYPE OF MONUMENT 3/4" X 3/4" IRON BAR SET


CORNER NO. 78
 SECTION 7E
 TOWN 5N
 RANGE 3N

FIELD BOOK: 96-17
 PAGE (15)

BASIS FOR MONUMENT LOCATION

(Use reverse side if necessary)


Show info such as: History of corner, with reference to Vol. and pg., dates, surveyor; exact description of monument replaced; if location computed, by taped or EDM traverse; landowner, remarks, etc.

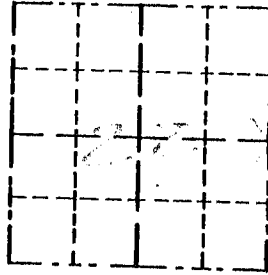

LOCATION
(Indicated by "X")



SEAL:

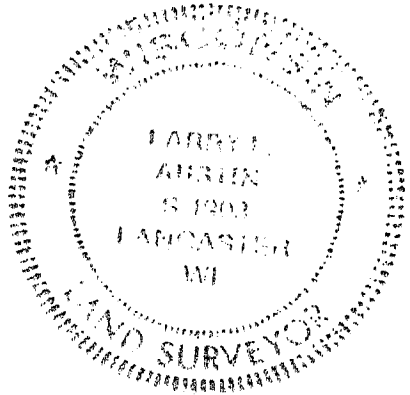

CORNER SET BY HARVEY CLARK. NO RECORD OF CORNER FOUND SINCE ORIGINAL SURVEYS. CORNER SET MIDWAY AND ONLINE BETWEEN NE CORNER AND THE SE CORNER SECTION 22. VERIFIED ITS LOCATION USING EDM METHODS.

CERTIFIED CORRECT,


Harvey Austin
 Registered Land Surveyor

DATE: 7-30-97

TIE SKETCH

Show at least three (3) ties and monument

- 3/4" IRON BAR SET
- 3/4" IRON BAR SET
- 1/2" X 15" IRON BAR SET AS TIES

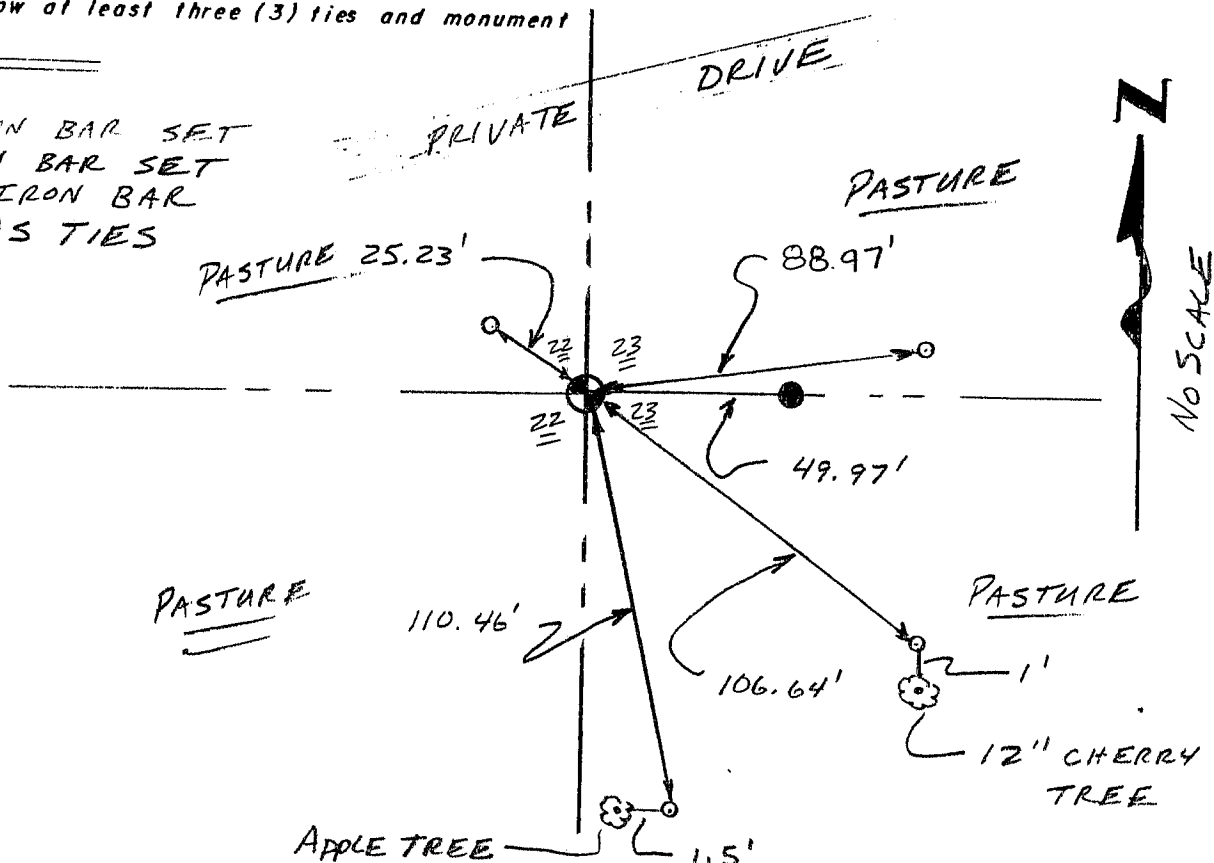

No SCALE