

REC'D JAN 29 1996

Survey Monument Record

CORNER NO. 96

SECTION 28

TOWN 5N

RANGE 3W

TYPE OF MONUMENT 3/4" IRON ROD FOUND


STATE PLANE COORDINATES: N \_\_\_\_\_  
E \_\_\_\_\_

ELEVATION — M.S.L. DATUM: \_\_\_\_\_

THETA ANGLE: \_\_\_\_\_

FIELD BOOK: 95-10

PAGE 24

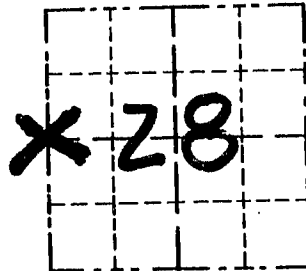

LOCATION  
(Indicated by "X")

BASIS FOR MONUMENT LOCATION

(Use reverse side if necessary)

- 3/4" IRON BAR FOUND AT OCCUPIED FENCE CORNER.
- BAR WAS SET IN CONJUNCTION WITH 1984 MALLIET SURVEY FOR THE CITY OF LANCASTER.

SEAL:



- PLACED A GRANT COUNTY ALUMINUM CAP OVER BAR AFTER VERIFICATION BY EDM TRAVERSE OF THE AREA

CERTIFIED CORRECT

*[Signature]*  
Registered Land Surveyor

DATE: 1/19/96

TIE SKETCH

Show at least three (3) ties and monument

