

GRANT COUNTY

REC'D JAN 29 1996

Survey Monument Record

CORNER NO. 111
 SECTION 30
 TOWN 5N
 RANGE 3W

TYPE OF MONUMENT GRANT Co. Alum. Mon. SET


STATE PLANE COORDINATES: N _____
E _____

ELEVATION — M.S.L. DATUM: _____

THETA ANGLE: _____

FIELD BOOK: 95-13

PAGE (31)

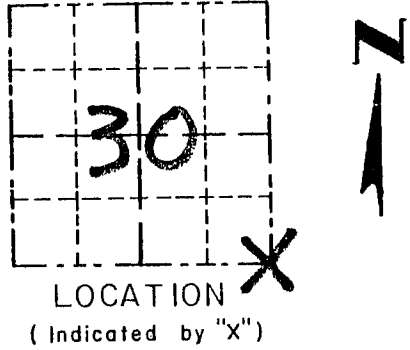

BASIS FOR MONUMENT LOCATION

(Use reverse side if necessary)

GRANT COUNTY ALUMINUM
 MONUMENT SET AT
 OCCUPIED FENCE CORNER
 AFTER VERIFICATION BY EDM
 TRAVERSE OF THE AREA

SEAL:

CERTIFIED CORRECT
Randy R. Hunt
 Registered Land Surveyor
 DATE: 1/8/96

TIE SKETCH

Show at least three (3) ties and monument

LEGEND

- ⊕ GRANT COUNTY Alum. MON. SET
- 1" x 1/2" IRON PIPE PLACED AS TIE
- EXISTING FENCE

