

REC'D JAN 29 1996

GRANT COUNTY

Survey Monument Record

TYPE OF MONUMENT 3/4" x 24" IRON BAR SET

STATE PLANE COORDINATES: N _____
E _____


ELEVATION — M.S.L. DATUM: _____

THETA ANGLE: _____

FIELD BOOK: 95-13

PAGE (32)

CORNER NO. 112
SECTION 30
TOWN 5N
RANGE 3W

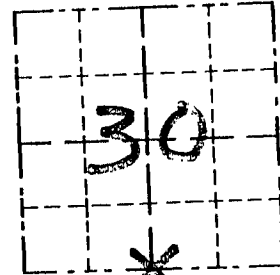

LOCATION
(Indicated by "X")

BASIS FOR MONUMENT LOCATION

(Use reverse side if necessary)

A 3/4" x 24" IRON BAR SET
18" BELOW SURFACE MIDWAY
AND ON LINE BETWEEN
SOUTHWEST COR AND SOUTHEAST
CORNER OF SECTION 30 AFTER
VERIFICATION BY EDM TRAVERSE
OF THE AREA

SEAL:

CERTIFIED CORRECT

Randy P. Burt
Registered Land Surveyor

DATE: 1/8/96

TIE SKETCH

Show at least three (3) ties and monument

