

GRANT COUNTY

REC'D JAN 29 1996

Survey Monument Record

TYPE OF MONUMENT GRANT Co. Alum. Mon

STATE PLANE COORDINATES: N _____
E _____

ELEVATION — M.S.L. DATUM: _____

THETA ANGLE: _____

FIELD BOOK: 95-13

PAGE (31)

CORNER NO. 75


SECTION 30

TOWN 5N

RANGE 3W

BASIS FOR MONUMENT LOCATION

(Use reverse side if necessary)

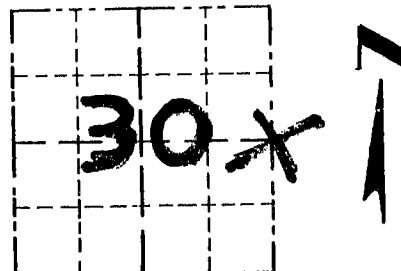

LOCATION
(Indicated by "X")

GRANT COUNTY ALUMINUM
MONUMENT PLACED AT
FENCE INTERSECTION AFTER
VERIFICATION BY EDM
TRAVERSE OF THE AREA.

SEAL:

CERTIFIED CORRECT

Kerry P. Rust
Registered Land Surveyor

DATE: 1/8/96

TIE SKETCH

Show at least three (3) ties and monument

