


# U. S. PUBLIC LAND SURVEY MONUMENT RECORD

**INSTRUCTIONS:** This record shall show the location of the corner and shall include all of the following nine elements (a through i).

(a) Identify the corner by reference to the U.S. public land survey system.

○ = Corner monument restored.

*The South Quarter Corner  
of Section 35, Town 5 North,  
Range 3 West, City of Lancaster,  
Grant County, Wisconsin.*

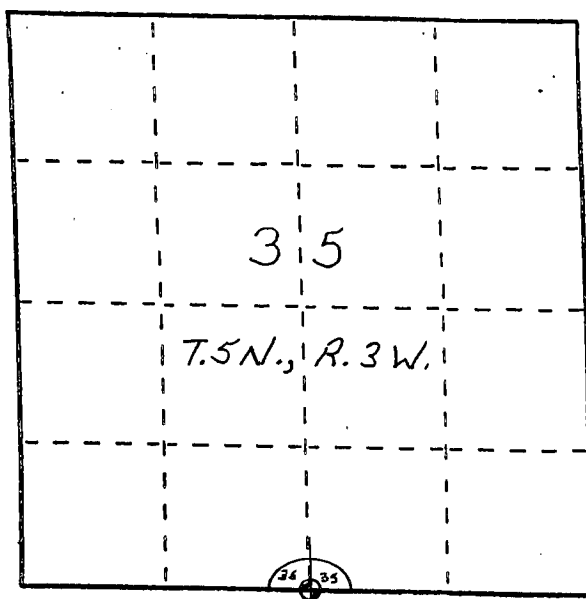


(b) Describe any record evidence, monument evidence, occupational evidence, testimonial evidence or any other material evidence you considered, and whether the monument was found or placed.

*I found a railroad spike noted by Thomas L. Buck on a tie sheet dated May 6, 1999. Recent road construction had removed some of his reference monuments. This location agrees with existing monumentation of Skyview Subdivision No 2 and one remaining tie from Douglas Malliet's tie sheet dated 4-18-83.*

(c) In the plan view drawing below, provide reference ties to at least 4 witness monuments, or, if the location is within a municipality, to at least 2 witness monuments. (Witness monuments shall be made of concrete, natural stone, iron or other equally durable material) Describe witness monuments.

(d) Show a plan view drawing depicting the relevant monuments and reference ties which is sufficient in detail to enable accurate relocation of the corner monument if the corner monument is disturbed. Indicate north.

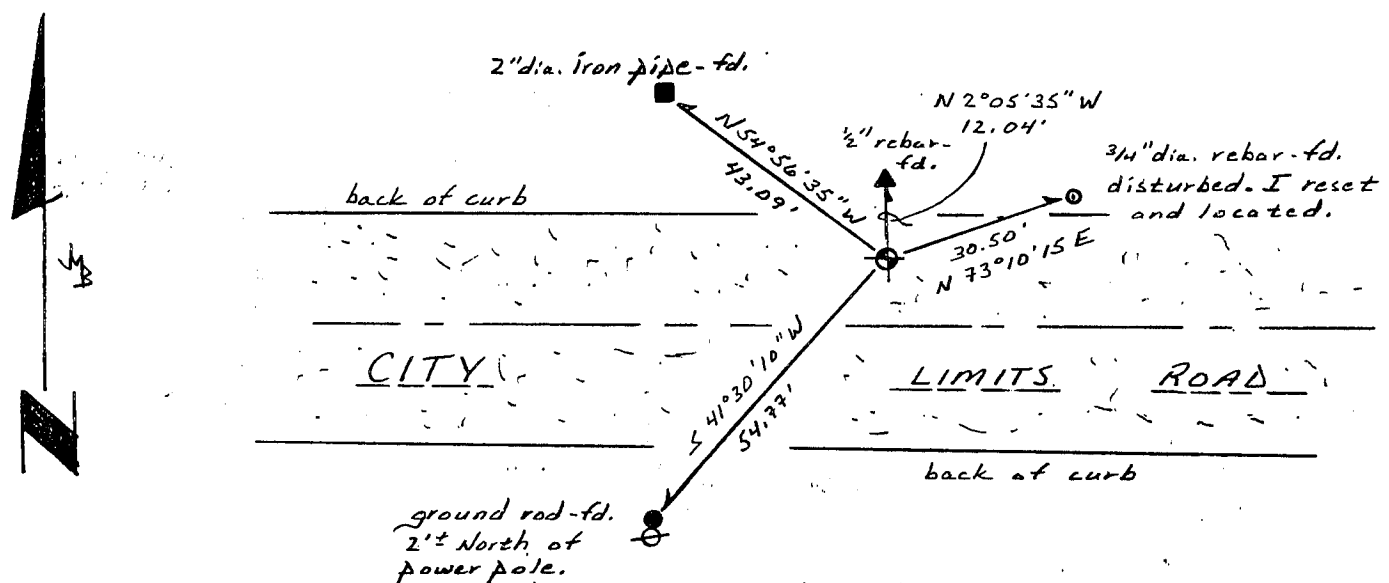

SCALE: 1" = 30'

(e) Describe any material discrepancy between the location of the corner as restored or reestablished and the location of that corner as previously restored or reestablished by distance and direction. Show the discrepancy on the plan view drawing under (d), above. Show the distances between the corner as previously restored or reestablished and (1) the corner as restored or reestablished, and (2) to at least 2 of the witness monuments shown on the drawing in (d), above.


*None.*

(f) Was the corner restored through acceptance of (1) an obliterated evidence location, or, (2) a found perpetuated location?

*A found perpetuated location.*

(g&h) Was the corner reestablished through lost corner proportionate methods? If so, show the method, including the directions and distances to other public land survey corners used as evidence or used for proportioning in determining the corner location?

*No.*

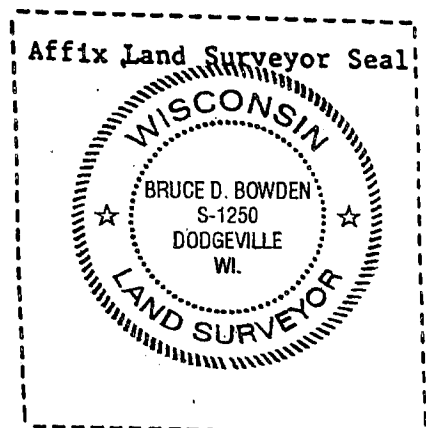

(1) *Bruce D. Bowden*

(type or print name) certify that the corner location shown on this record was determined by me or under my direction and control and that this U.S. Public Land Survey Monument Record is correct and complete to the best of my knowledge and belief.

*Bruce D. Bowden*  
Signature

*April 1, 2004*  
Date

# Survey Monument Record


TYPE OF MONUMENT RAIL ROAD SPIKE  
 STATE PLANE COORDINATES: N \_\_\_\_\_  
 E \_\_\_\_\_  
 ELEVATION — M.S.L. DATUM: \_\_\_\_\_  
 THETA ANGLE: \_\_\_\_\_  
 FIELD BOOK: \_\_\_\_\_  
 PAGE \_\_\_\_\_

CORNER NO. \_\_\_\_\_  
 SECTION 35  
 TOWN 5 NORTH  
 RANGE 3 WEST

## BASIS FOR MONUMENT LOCATION

(Use reverse side if necessary)


Show info such as: History of corner, with reference to Vol. and pg., dates, surveyor; exact description of monument replaced; if location computed, by taped or EDM traverse; landowner, remarks, etc.

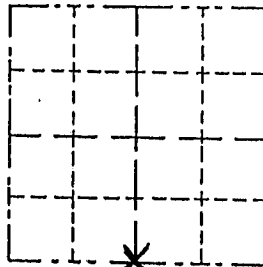

LOCATION  
 (Indicated by "X")

- FOUND PERPETUATED LOCATION
- OBLITERATED EVIDENCE LOCATION
- LOST CORNER (RESTORED BY PROPORTIONATE METHODS)

THE LOCATION OF THIS MONUMENT WAS COMPLETELY OBLITERATED. I DIDN'T FIND ANY OF THE TIES. I ASSUME THEY WERE DESTROYED WHEN THE ROAD WAS WIDENED. I TIED INTO LARRY AUSTIN'S SURVEY NEXT TO MINE AND BACKED THIS CORNER IN. I ALSO TIED INTO SKYVIEW SUBDIVISION FOR A CHECK AND EVERYTHING CHECKED VERY WELL.

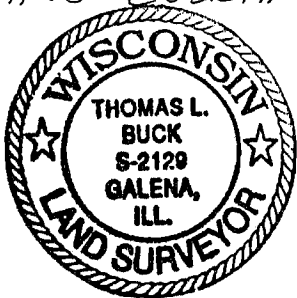

CERTIFIED CORRECT TO THE BEST  
 OF MY KNOWLEDGE AND BELIEF

Thomas L. Buck  
 Registered Land Surveyor

DATE: 5/6/99


## TIE SKETCH

Show at least three (3) ties and monument



NO SCALE

- = POWER POLE
- = 1/2" IRON ROD
- = RR. SPIKE

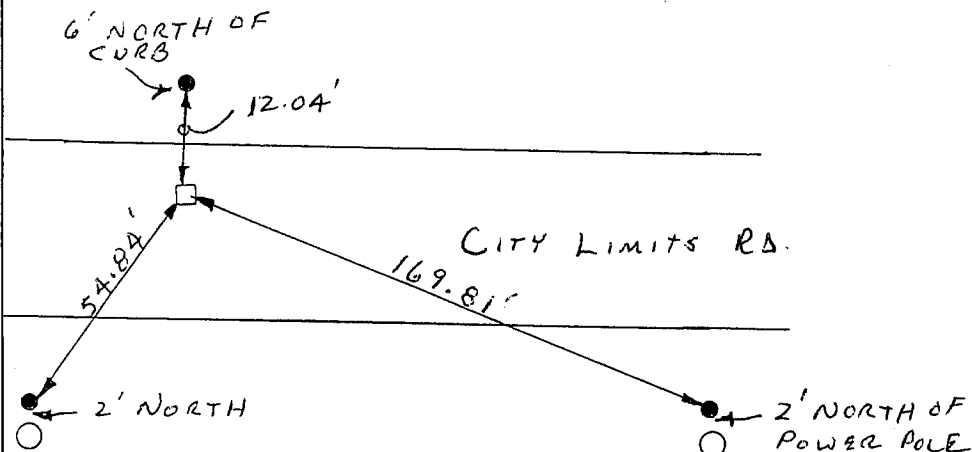

North Lancaster Township

US. PUBI 'S LAND SURVEY MONUMENT RECORD

CORNER DESCRIPTION: S 1/4 CORNER, SECTION 35, T 5 N, R 3 W

STATE PLANE COORDINATES: N \_\_\_\_\_, E \_\_\_\_\_


THETA ANGLE: \_\_\_\_\_

HORIZONTAL DATUM: WISCONSIN STATE PLANE COORDINATE SYSTEM, SOUTH ZONE

EVIDENCE: No CORNER MONUMENT OF RECORD - NO OCCUPATION EVIDENCE IN PROXIMITY

MONUMENT: FOUND  , PLACED   
METHOD OF RESTORATION (RE-ESTABLISHMENT):  
 ACCEPTED EXISTING MONUMENT  
N  , E  ACCEPTED OCCUPATION  
N  , E  LOST CORNER PROPORTIONATE METHODS  
DATE CORNER SET: 4-18-82  
KED, DJM

- LEGEND
- ▲ SET #6 REBAR, 113 LBS PER LINEAL FT. MIN. WT.
  - SET 1" X 24" IRON PIPE, 413 LBS. PER LINEAL FT. MIN. WT.
  - SET 2" X 30" IRON PIPE, 3.65 LBS. PER LINEAL FT. MIN. WT.
  - FOUND 1" IRON PIPE
  - FOUND 2" IRON PIPE
  - FOUND R/R SPIKE
  - SET R/R SPIKE
  - ⊙ GOVERNMENT CORNER
  - EXISTING FENCE

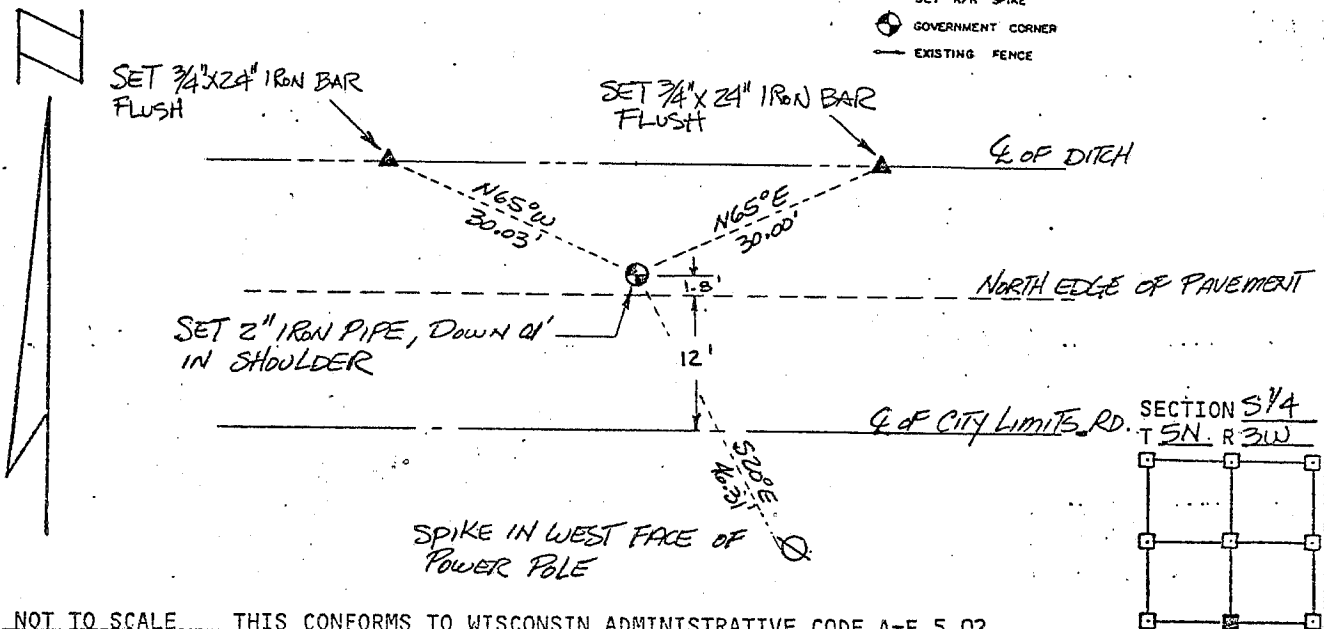

NOT TO SCALE THIS CONFORMS TO WISCONSIN ADMINISTRATIVE CODE A-E 5.02

SURVEYOR'S AFFIDAVIT:

STATE OF WISCONSIN)  
GRANT COUNTY) SS

I hereby certify that I, DOUGLAS J. MALLIET, have complied with the Wisconsin State Statutes, Statutes of the United States, and the rules and regulations made by the Secretary of the Interior in the location of the corner shown above.

DATE OF SURVEY: 4-18-83

Douglas J. Malliet  
REGISTERED LAND SURVEYOR  
# 1266



D. F. BURBACH MUNICIPAL & CIVIL ENGINEERS

410 NORTH SECOND STREET • PLATTEVILLE, WISCONSIN 53818 • (608) 348-3262

MAY 24 1983

0-1294