


# GRANT COUNTY

## Survey Monument Record

TYPE OF MONUMENT ALUM. MONUMENT  
 STATE PLANE COORDINATES: N \_\_\_\_\_  
 E \_\_\_\_\_  
 ELEVATION — M.S.L. DATUM: \_\_\_\_\_  
 THETA ANGLE: \_\_\_\_\_  
 FIELD BOOK: 94-11  
 PAGE 16

CORNER NO. 42  
 SECTION 13  
 TOWN E 11  
 RANGE 4 W

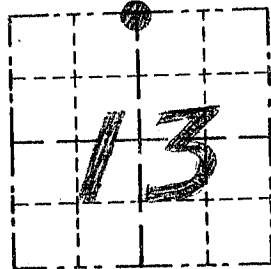

LOCATION  
 (Indicated by "●")


### BASIS FOR MONUMENT LOCATION

(Use reverse side if necessary)

Show info such as: History of corner, with reference to Vol. and pg., dates, surveyor; exact description of monument replaced; if location computed, by taped or EDM traverse; landowner, remarks, etc.

*MONUMENT PLACED BASED ON OCCUPATIONAL EVIDENCE, NO RECORD FOUND OF COR. SINCE ORIGINAL SURVEYS*

SEAL:

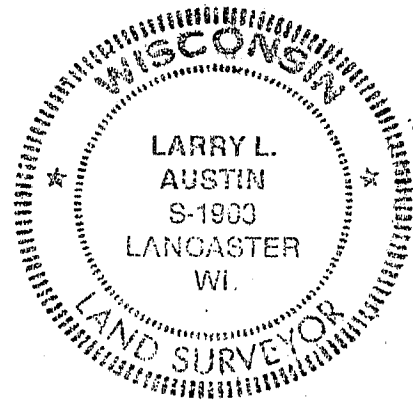


CERTIFIED CORRECT

*Larry L. Austin*  
 Registered Land Surveyor

DATE: 6/6/94

### TIE SKETCH

Show at least three (3) ties and monument

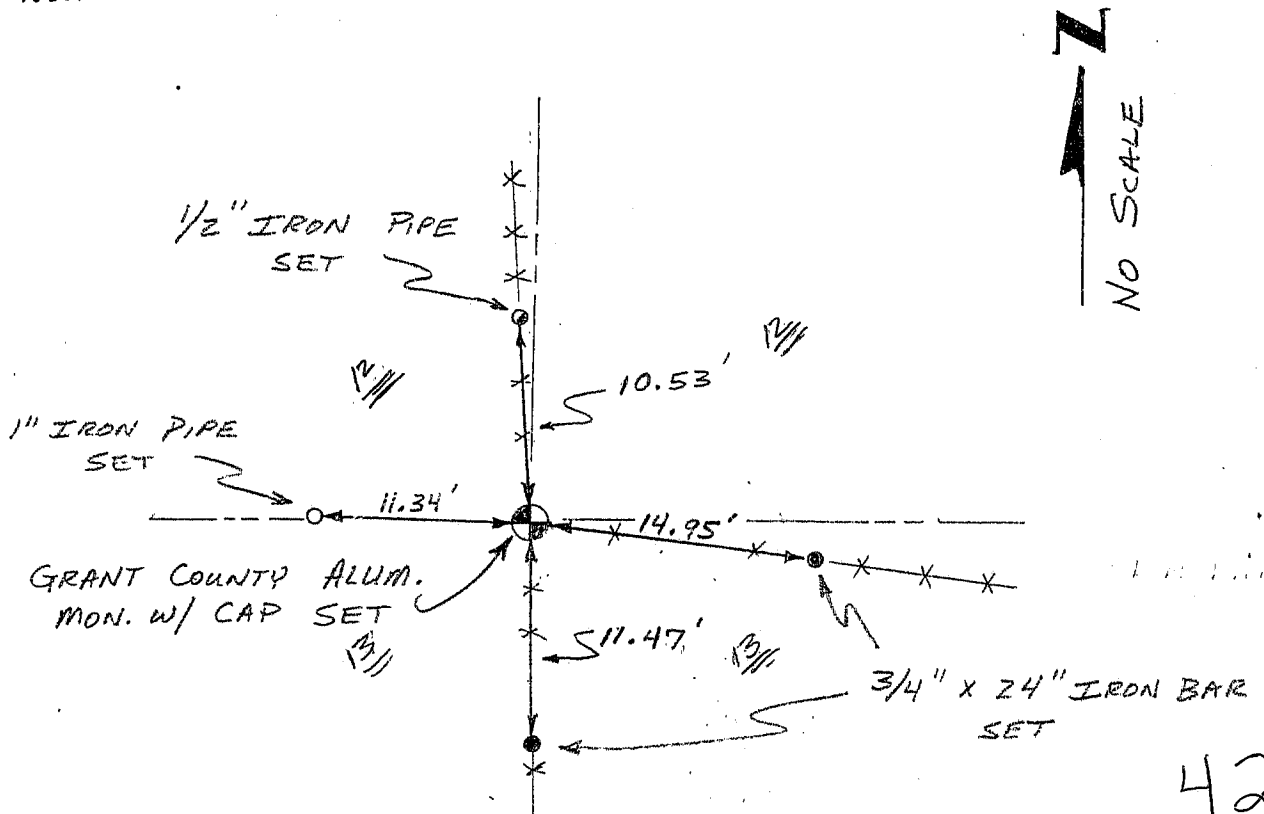

NO SCALE

42