


GRANT COUNTY

Survey Monument Record

TYPE OF MONUMENT PK NAIL FOUND
STATE PLANE COORDINATES: N _____
E _____
ELEVATION — M.S.L. DATUM: _____
THETA ANGLE: _____
FIELD BOOK: 94-11
PAGE 28

CORNER NO. 59
SECTION 14
TOWN 5 N
RANGE 4 W

E 1/4 CORNER

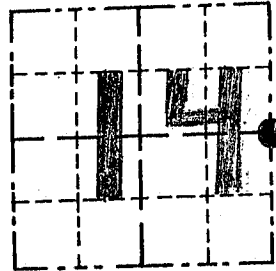

LOCATION
(Indicated by "●")

BASIS FOR MONUMENT LOCATION

(Use reverse side if necessary)

Show info such as: History of corner, with reference to Vol. and pg., dates, surveyor; exact description of monument replaced; if location computed, by taped or EDM traverse; landowner, remarks, etc.

SEAL:

No RECORD FOUND OF CORNER SINCE ORIGINAL SURVEYS; FOUND A PK NAIL IN CONCRETE BASE FOR CORNER POST. I ACCEPTED ITS LOCATION & VERIFIED IT BY EDM TRAVERSE IN THE AREA.




CERTIFIED CORRECT

Larry L. Austin
Registered Land Surveyor

DATE: 10/2/94

TIE SKETCH

Show at least three (3) ties and monument

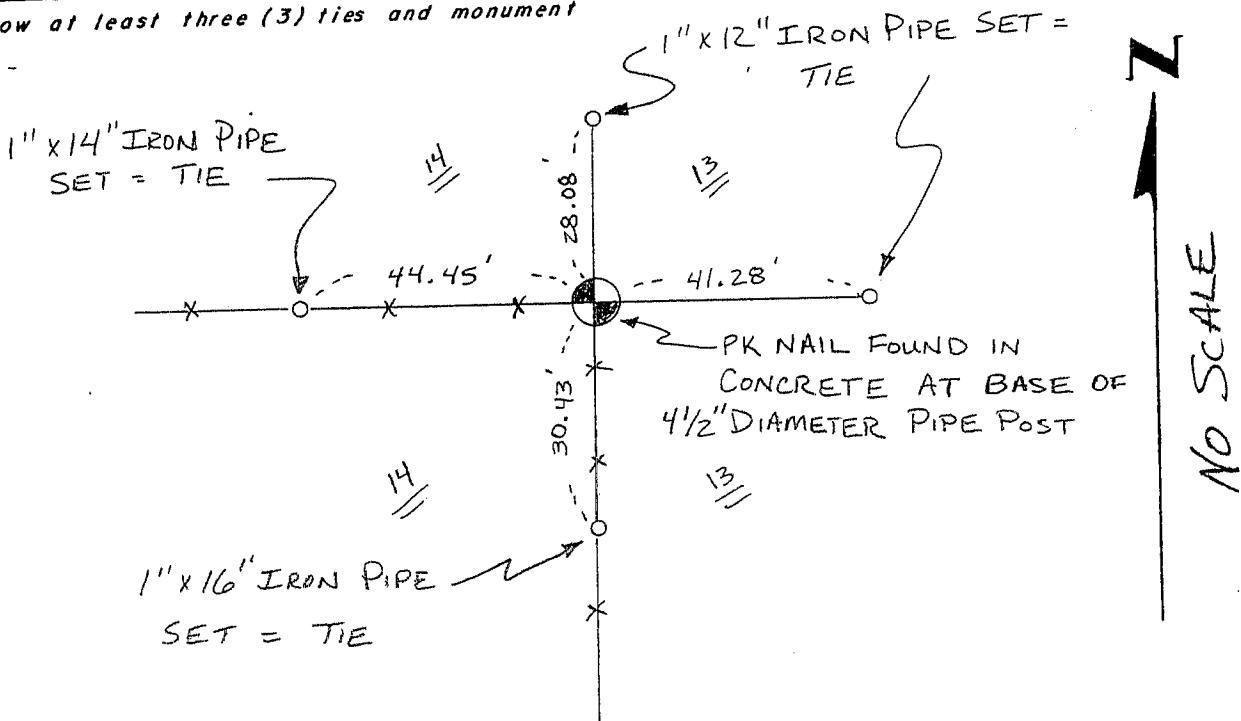

NO SCALE