


U.S. PUBLIC LAND SURVEY MONUMENT RECORD

Section 21, Town 5 North Range 4 West, Town of Little Grant, Grant County, Wisconsin

CERTIFICATE

I, Larry L. Austin, do hereby certify that the corner location on this record was determined by me and/or under my direct supervision and that this U.S. public land survey monument record is correct and complete to the best of my knowledge and belief.

Larry L. Austin
Larry L. Austin, S-1903

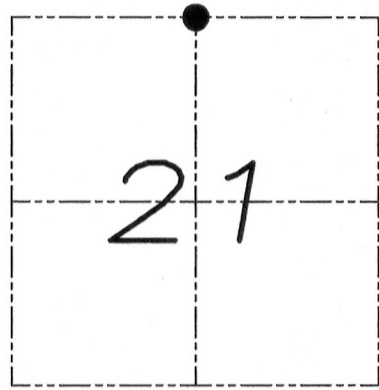

● = CORNER LOCATION

HISTORY OF CORNER


Corner was originally set in 1833 by Harvey Parke. In 1857 Whitney Hayden tied to the corner with no mention of the monument. No other record of the corner was found.

CORNER EVIDENCE FOUND

I reset this corner at an occupied location and verified its location by EDM and GPS methods.

DESCRIPTION OF CORNER AND WITNESS MONUMENTS, references and accessories used to perpetuate the original or re-established location of this corner. Witnesses to monument location Bobby Sedgwick & Brad Digman & Shane Austin

SKETCH:

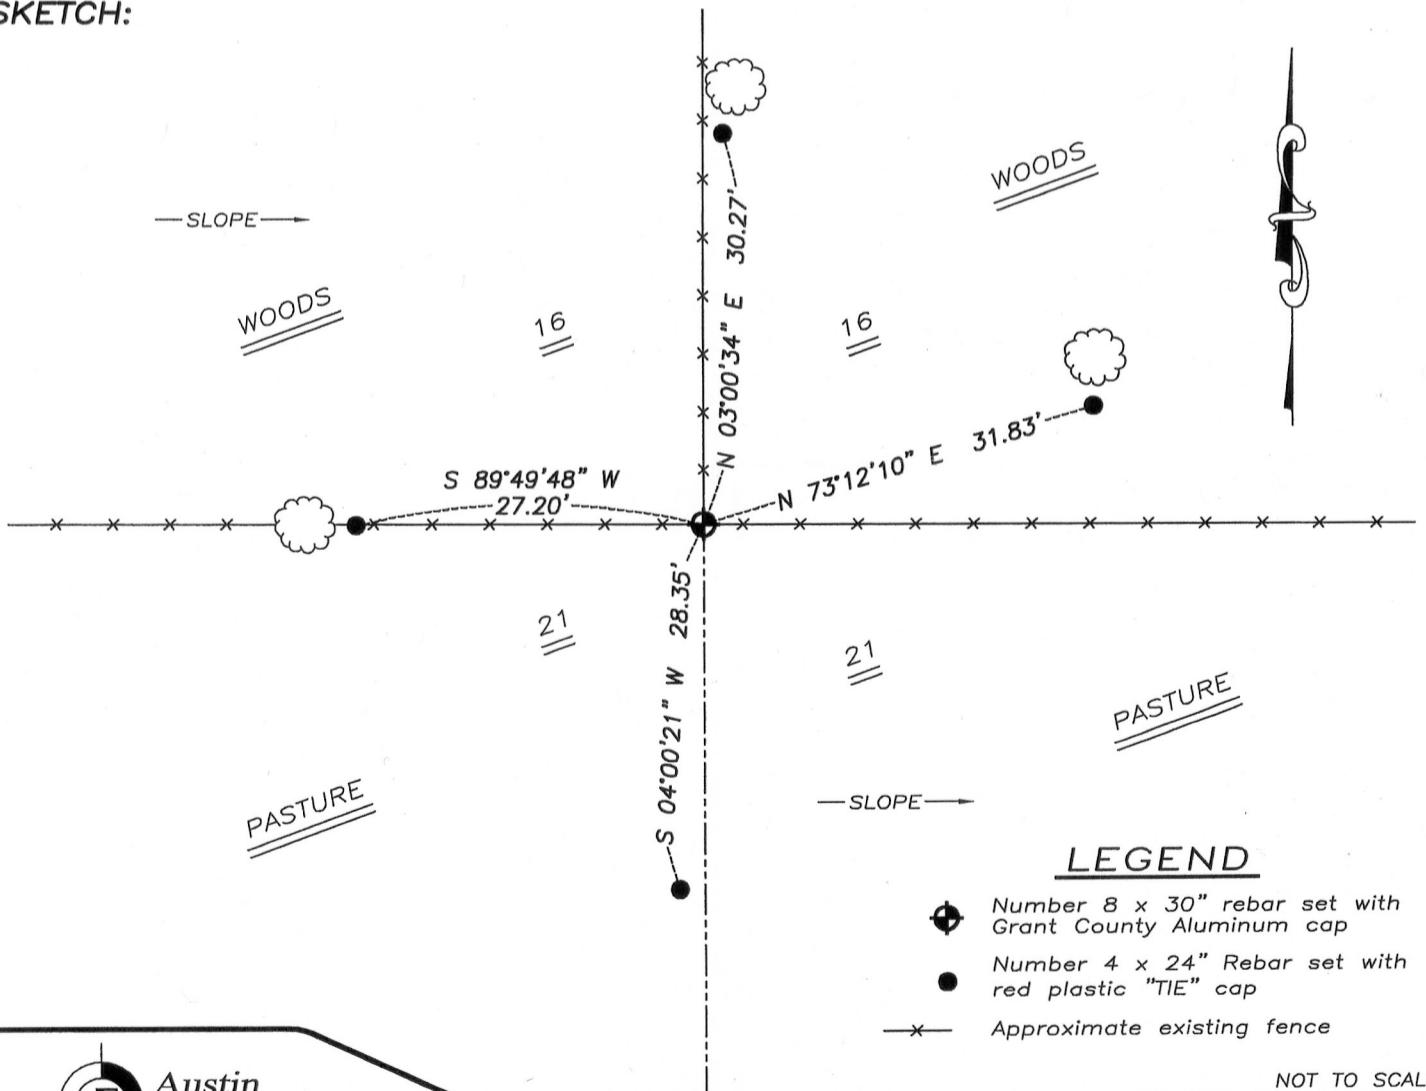

LEGEND

- Number 8 x 30" rebar set with Grant County Aluminum cap
- Number 4 x 24" Rebar set with red plastic "TIE" cap
- x- Approximate existing fence

NOT TO SCALE



4211 HWY 81 E, LANCASTER, WI 53813
PHONE: 608-723-6363 FAX: 608-723-6702

JOB NUMBER 09S185-SCHMIDT
FIELDBOOK: TDSR, 2904
G:\T5NR4W\28
H:\TIE\T5NR4W\68

DRAWN BY: SW AUSTIN
APPROVED: LL AUSTIN

68

JAN 23 2012