


# GRANT COUNTY

## Survey Monument Record

TYPE OF MONUMENT Alum. Mon. PLACED  
 STATE PLANE COORDINATES: N \_\_\_\_\_  
 E \_\_\_\_\_  
 ELEVATION — M.S.L. DATUM: \_\_\_\_\_  
 THETA ANGLE: \_\_\_\_\_  
 FIELD BOOK: 94-19  
 PAGE: 35

CORNER NO. 55  
 SECTION 17  
 TOWN 5N  
 RANGE 4W  
W 1/4 Cor.

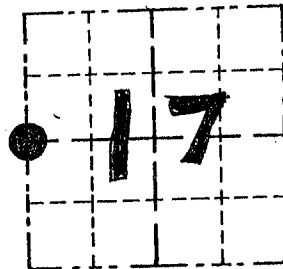

LOCATION  
 (Indicated by ●)


### BASIS FOR MONUMENT LOCATION

(Use reverse side if necessary)

Show info such as: History of corner, with reference to Vol. and pg., dates, surveyor; exact description of monument replaced; if location computed, by taped or EDM traverse; landowner, remarks, etc.

SEAL:

NO RECORD OF CORNER FOUND SINCE ORIGINAL SURVEYS; CORNER LOCATION ESTABLISHED BASED ON OCCUPATIONAL EVIDENCE & VERIFIED BY EDM TRAVERSE OF THE AREA.

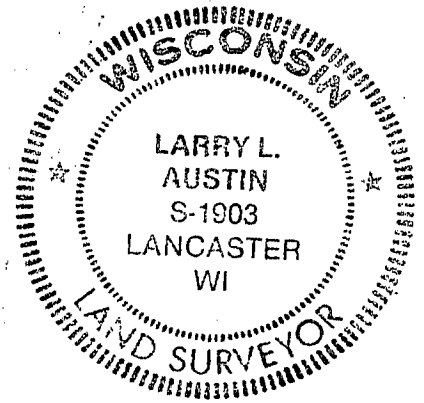

CERTIFIED CORRECT

*Larry L. Austin*  
 Registered Land Surveyor

DATE: 1-16-95

### TIE SKETCH

Show at least three (3) ties and monument

- LEGEND
- GRANT COUNTY ALUM. MON. PLACED
  - 1" IRON PIPES PLACED
  - xx EXISTING FENCE

