


# Survey Monument Record

TYPE OF MONUMENT 3/4" X 24"  
 STATE PLANE COORDINATES: N \_\_\_\_\_  
 E \_\_\_\_\_  
 ELEVATION — M.S.L. DATUM: \_\_\_\_\_  
 THETA ANGLE: \_\_\_\_\_  
 FIELD BOOK: \_\_\_\_\_  
 PAGE \_\_\_\_\_

CORNER NO. \_\_\_\_\_  
 SECTION 27  
 TOWN 5 NORTH  
 RANGE 4 WEST

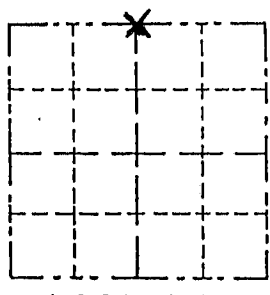


LOCATION  
 (Indicated by "X")

- FOUND PERPETUATED LOCATION
- OBLITERATED EVIDENCE LOCATION
- LOST CORNER (RESTORED BY PROPORTIONATE METHODS)

## BASIS FOR MONUMENT LOCATION

(Use reverse side if necessary)  
 Show info such as: History of corner, with reference to Vol. and pg., dates, surveyor; exact description of monument replaced; if location computed, by taped or EDM traverse; landowner, remarks, etc.

THE MONUMENT WAS PLACED AT THE OCCUPIED FENCE CORNER AFTER A COMPLETE SURVEY BY AN EDM TRAVERSE OF SECTION 27.

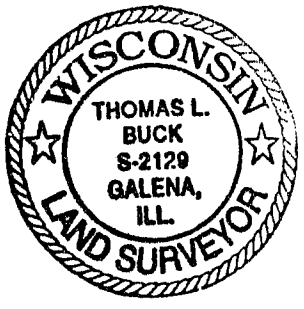


CERTIFIED CORRECT TO THE BEST OF MY KNOWLEDGE AND BELIEF

Thomas L. Buck  
 Registered Land Surveyor

DATE: 5/6/99

## TIE SKETCH

Show at least three (3) ties and monument

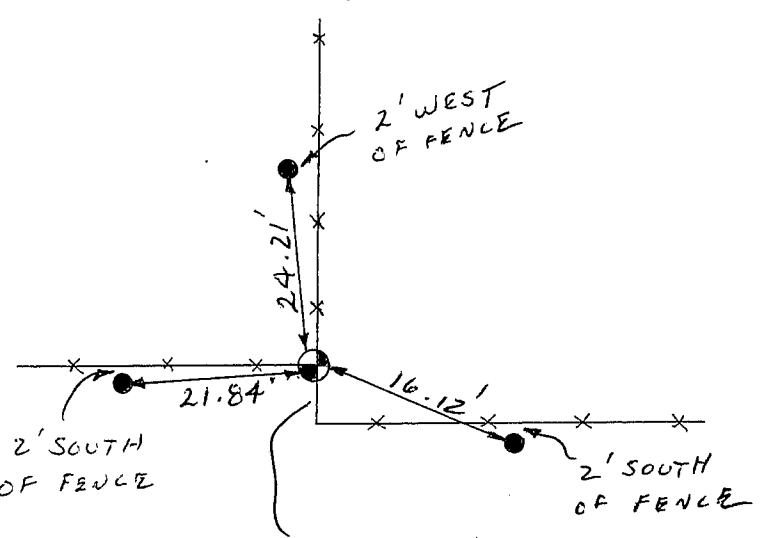

NO SCALE

- = 3/4" X 24" IRON ROD SET
- = 1/2" IRON ROD
- = EXISTING FENCE

NOTE: 4.82' JOG IN FENCE CORNERS DUE TO BOW IN SOUTHERLY FENCE LINE.