

Survey Monument Record

CORNER NO. _____

SECTION 36

TOWN T5N

RANGE R4W

TYPE OF MONUMENT 3/4" X 24" IRON ROD W/CAP


STATE PLANE COORDINATES: N _____
E _____

ELEVATION — M.S.L. DATUM: _____

THETA ANGLE: _____

FIELD BOOK: _____

PAGE _____

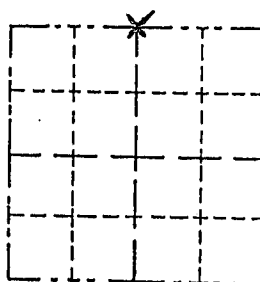

LOCATION

(Indicated by "X")


- FOUND PERPETUATED LOCATION
- OBLITERATED EVIDENCE LOCATION
- LOST CORNER (RESTORED BY PROPORTIONATE METHODS)

BASIS FOR MONUMENT LOCATION

(Use reverse side if necessary)

Show info such as: History of corner, with reference to Vol. and pg., dates, surveyor; exact description of monument replaced; if location computed, by taped or EDM traverse; landowner, remarks, etc.

I FOUND NO FIELD EVIDENCE OF THIS CORNER. I SET IT BY USING THE OCCUPIED NW CORNER OF THE SE 1/4 AND THE NW CORNER OF THE SW 1/4 OF THE SE 1/4. THIS FIT WELL WITH THE OTHER CORNERS IN THE SECTION. THIS LOCATION WAS VERIFIED BY USING E.D.M. AND G.P.S. SURVEY OF SECTION 36 + PART OF SECTION 25.

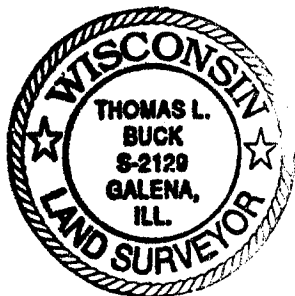


CERTIFIED CORRECT TO THE BEST OF MY KNOWLEDGE AND BELIEF

Thomas L. Buck
Registered Land Surveyor

DATE: 8/9/00

TIE SKETCH

Show at least three (4) ties and monument

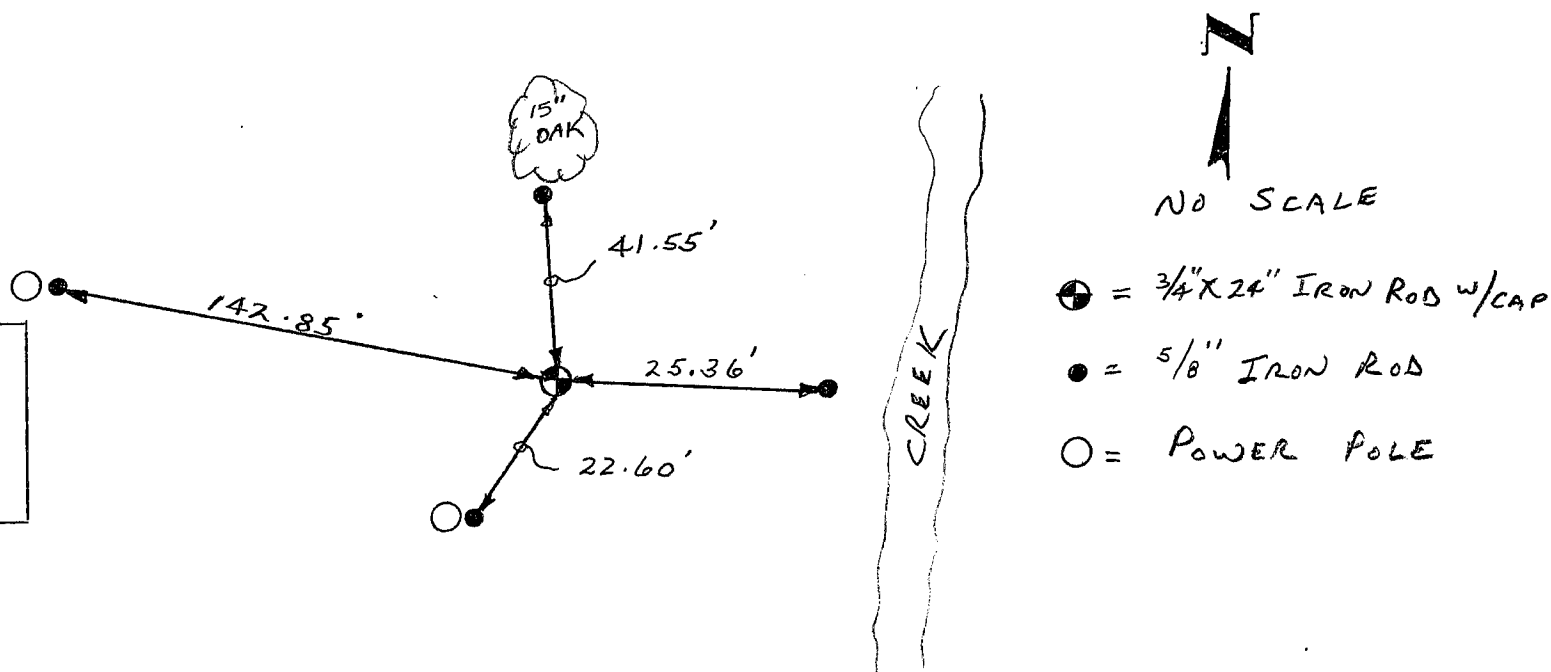

NO SCALE

- = 3/4" X 24" IRON ROD W/CAP
- = 5/8" IRON ROD
- = POWER POLE