


Survey Monument Record

CORNER NO. _____
 SECTION 36
 TOWN T5N
 RANGE R4W

TYPE OF MONUMENT 3/4" X 24" IRON ROD W/CAP
 STATE PLANE COORDINATES: N _____
 E _____
 ELEVATION — M.S.L. DATUM: _____
 THETA ANGLE: _____
 FIELD BOOK: _____
 PAGE _____

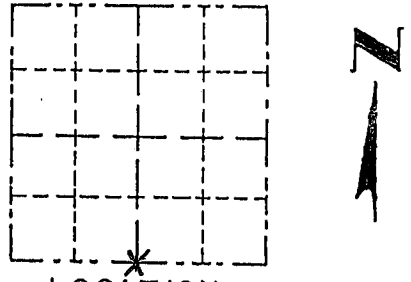

LOCATION
 (Indicated by "X")


- FOUND PERPETUATED LOCATION
- OBLITERATED EVIDENCE LOCATION
- LOST CORNER (RESTORED BY PROPORTIONATE METHODS)

BASIS FOR MONUMENT LOCATION

(Use reverse side if necessary)

Show info such as: History of corner, with reference to Vol. and pg., dates, surveyor; exact description of monument replaced; if location computed, by taped or EDM traverse; landowner, remarks, etc.

I FOUND NO EVIDENCE OF THIS CORNER. I SET IT BY USING THE OCCUPIED SE. CORNER OF THE SE. 1/4 AND SE. CORNER OF THE SW. 1/4 OF THE SE. 1/4. THIS LOCATION WAS VERIFIED BY USING E.D.M. AND G.P.S. SURVEY OF SECTION 36.

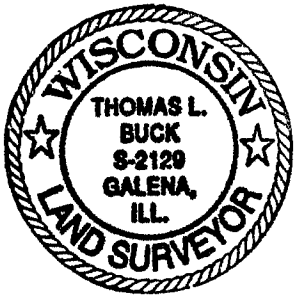


CERTIFIED CORRECT TO THE BEST OF MY KNOWLEDGE AND BELIEF

Thomas L. Buck
 Registered Land Surveyor
 DATE: 8/9/00

TIE SKETCH

Show at least three (4) ties and monument

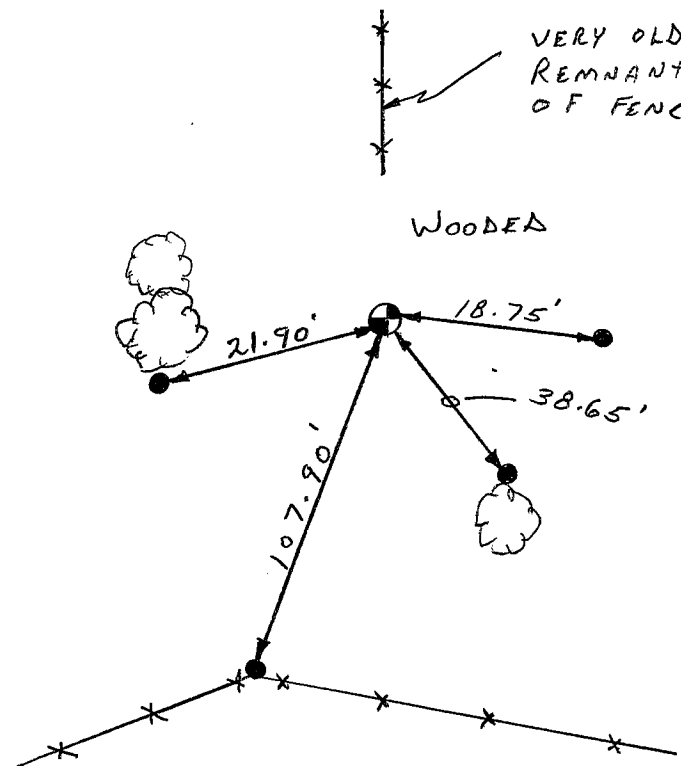

No SCALE

- ⊕ = 3/4" X 24" IRON ROD W/CAP
- = 5/8" IRON ROD
- X—X— = EXISTING FENCE