


Survey Monument Record

CORNER NO. 120
 SECTION 36
 TOWN T5N
 RANGE R4W

TYPE OF MONUMENT 3/4" x 24" IRON REBAR w/CAP
 STATE PLANE COORDINATES: N _____
 E _____
 ELEVATION — M.S.L. DATUM: _____
 THETA ANGLE: _____
 FIELD BOOK: _____
 PAGE _____

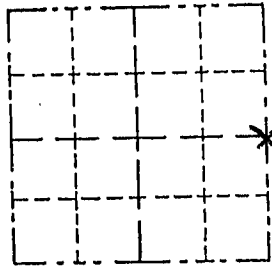

LOCATION
(Indicated by "X")


- FOUND PERPETUATED LOCATION
- OBLITERATED EVIDENCE LOCATION
- LOST CORNER (RESTORED BY PROPORTIONATE METHODS)

BASIS FOR MONUMENT LOCATION

(Use reverse side if necessary)

Show info such as: History of corner, with reference to Vol. and pg., dates, surveyor; exact description of monument replaced; if location computed, by taped or EDM traverse; landowner, remarks, etc.

SET THE MONUMENT AT THE OCCUPIED CORNER AFTER CHECKING TO THE MONUMENT TO THE NORTH AND THE OCCUPIED CORNER TO THE SOUTH. LOCATION VERIFIED BY USING E. D. M. AND G. P. S. SURVEY OF SECTION 36.

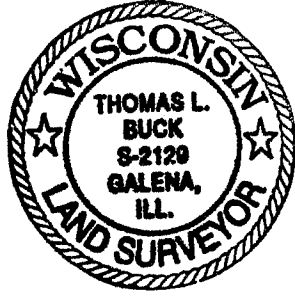


CERTIFIED CORRECT TO THE BEST OF MY KNOWLEDGE AND BELIEF

Thomas L. Buck
Registered Land Surveyor

DATE: 8/9/00

TIE SKETCH

Show at least three (4) ties and monument

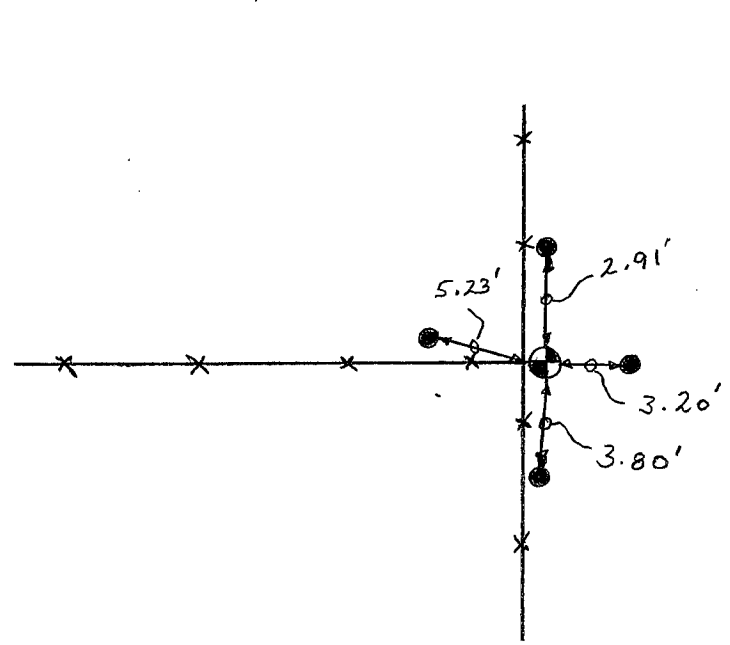

NO SCALE

- = 3/4" x 24" IRON REBAR w/CAP
- = 5/8" IRON REBAR
- = EXISTING FENCE