


Survey Monument Record

TYPE OF MONUMENT RAILROAD SPIKE
SET

CORNER NO. 19
SECTION 1
TOWN SN
RANGE SW

FIELD BOOK: 96-18
PAGE (25)

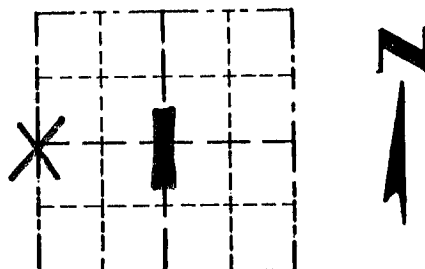

LOCATION
(Indicated by "X")

BASIS FOR MONUMENT LOCATION

(Use reverse side if necessary)

Show info such as: History of corner, with reference to Vol. and pg., dates, surveyor; exact description of monument replaced; if location computed, by taped or EDM traverse; landowner, remarks, etc.

SEAL:

CORNER SET IN 1832 BY ROBERT CLARK, NO RECORD OF CORNER FOUND SINCE ORIGINAL SURVEYS. CORNER WAS SET AT OCCUPIED LOCATION CENTERLINE / CENTERLINE. VERIFIED ITS LOCATION USING EDM METHODS.



CERTIFIED CORRECT

Larry L. Austin
Registered Land Surveyor
DATE: 1-27-97

TIE SKETCH

Show at least three (3) ties and monument

