


U.S. PUBLIC LAND SURVEY MONUMENT RECORD - GRANT COUNTY, WI
 Summary of Section 23, Town 5 North Range 5 West, Town of Bloomington

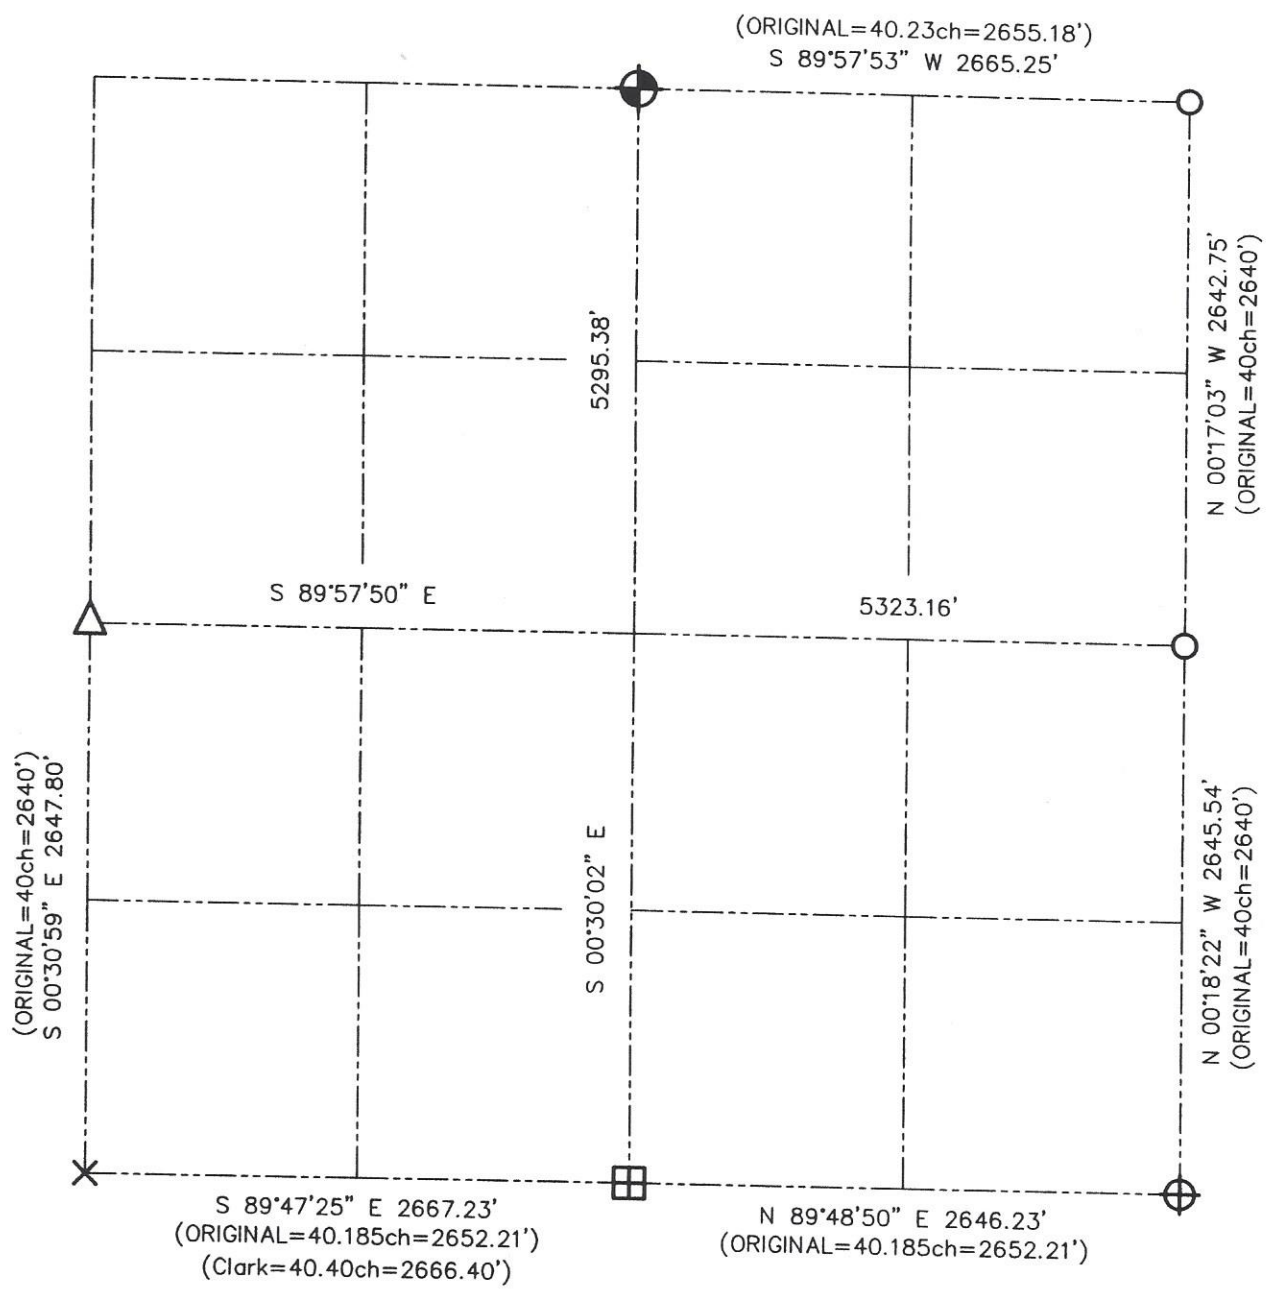

LEGEND

- NUMBER 8 x 30" REBAR SET WITH GRANT COUNTY ALUMINUM CAP
- 1" IRON PIPE FOUND
- CHISEL "X" FOUND
- CAST ALUMINUM MONUMENT FOUND
- NUMBER 6 IRON BAR FOUND
- ALUMINUM CAP IN ROCK OUTCROP FOUND
- RECORDED AS



Relationship of all section corners to other section corners shall be shown hereon by bearing and distance or grid coordinates. Bearing reference shown below.

Dated this 18th day of September, 2001



Bearings referenced to the North-South 1/4 line of Section 23, which is assumed to bear S 00°30'02" E.

SKETCH NOT TO SCALE

AUSTIN ENGINEERING, LLC
 4211 HWY 81 EAST, LANCASTER, WI 53813
 PHONE 608-723-6363 FAX 608-723-6702

FIELDBOOK: SDR33,
 G: \
 C: \SWA\TIE\

CREW: BS-SB-SA-TF
 DRAWN BY: SW AUSTIN
 APPROVED: LL AUSTIN