


U.S. PUBLIC LAND SURVEY MONUMENT RECORD - GRANT COUNTY, WI
 Section 24, Town 5 North Range 5 West, Town of Bloomington East

CERTIFICATE:

I, Jimmy D. Rose, do hereby certify that the corner location on this record was determined by me and/or under my direct supervision and that this U.S. Public Land Survey Monument Record is correct and complete to the best of my knowledge and belief.

Dated this 11th day of December, 2012


 Jimmy D. Rose S-1911

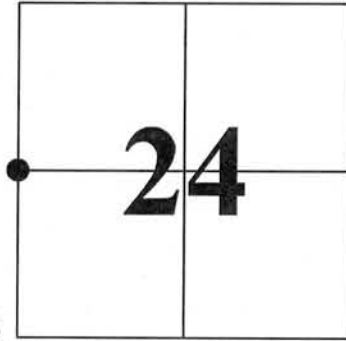

● = CORNER LOCATION

HISTORY OF CORNER ESTABLISHMENT: NO EVIDENCE OF CORNER RE-ESTABLISHMENT SINCE THE ORIGINAL GOVERNMENT SURVEYS WAS FOUND.


DESCRIPTION OF CORNER EVIDENCE FOUND: ESTABLISHED CORNER USING SURVEYS IN THE AREA AND AT A PROPORTIONAL DISTANCE BETWEEN THE NW AND SW CORNERS OF SECTION 24.

DESCRIPTION OF CORNER AND WITNESS MONUMENTS, references and accessories used to perpetuate the original or re-established location of this corner.

SKETCH:

LEGEND

- ▲ SET SURVEY MARKER NAIL IN PAVEMENT
- SET 5/8" DIA. REBAR
- X-X- EXISTING FENCE

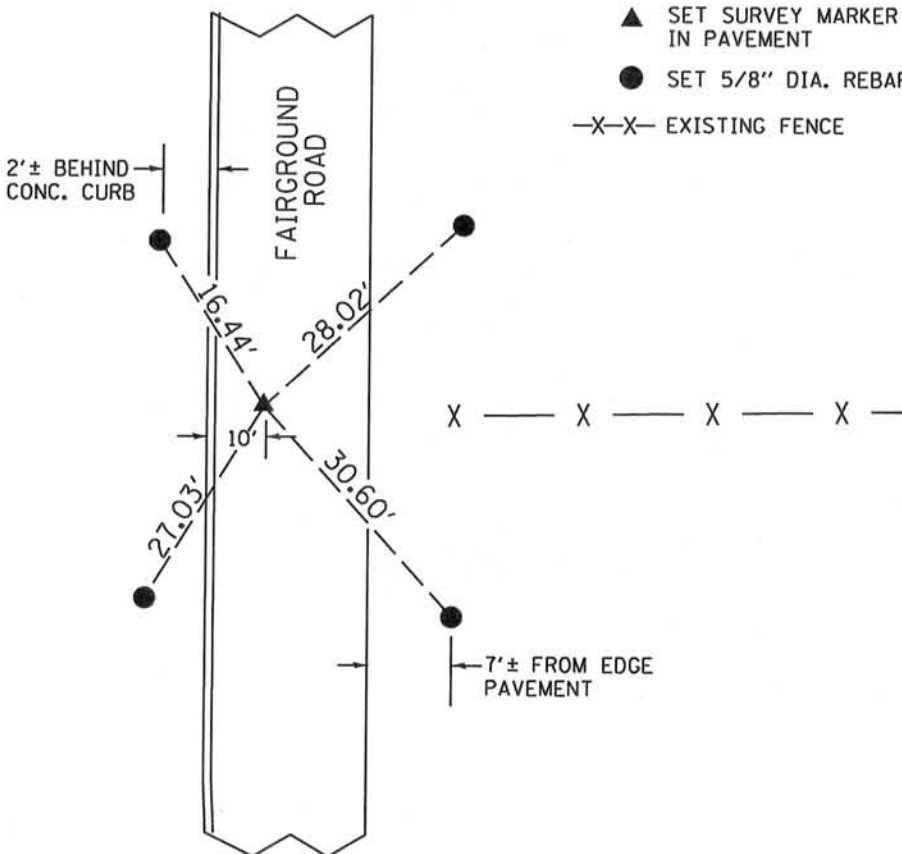

NOT TO SCALE