

CERTIFIED LAND CORNER

MAY 14 1991

STATE OF WISCONSIN )  
 COUNTY OF GRANT ) S.S.

126



CERTIFICATE

I, Ronald R. Hayden, do hereby certify that on the 1st day of April 1991, I found (evidence) ~~(no evidence)~~ of the S 1/4 corner of Section 34, T 5 N, R 5 W, Fourth Principal Meridian, and I re-established said corner according to the Wisconsin Statutes as shown and described hereon.

Dated this 1 day of April 1991

Ronald R. Hayden

Ronald R. Hayden, RLS-1500  
 Title

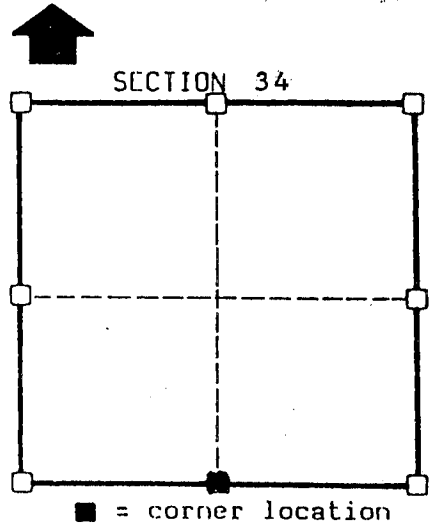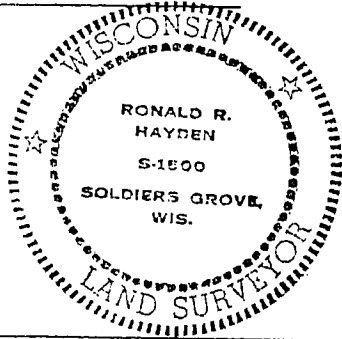

■ = corner location  
1 5 N R 5 W  
 Town of: Bloomington

Seal

History of original corner establishment:  
 1833 Original Survey. Section subdivision in 1851, by John Evert.

Description of corner evidence found: Found no evidence of the post or mound. Corner's location was determined from existing evidence found in the Section 34. Set 3/4" X 30" iron rebar.

Description of corner and witness monuments, references and accessories used to perpetuate the original or re-established location of this corner:

Witnesses to corner location:  
Ronald R. Hayden, RLS  
Robbie Hayden  
Steven Hayden

(See back for witness descriptions).

Sketch:

ASPEN ROAD

STATE TRUNK  
 NO. 133  
 WISCONSIN  
 HIGHWAY

SURVEY CONTROL ORDER				
Horizontal				
Vertical				
Corner	East(X)	North(Y)	Elevation(Z)	Zone
Control Sta. Name				

MAY 14 1991

## WITNESS DESCRIPTIONS

1. 3/4" X 30" iron rebar set for witness. Witness bears: N 65° W 85.73'.
2. 3/4" X 30" iron rebar set for witness. Witness bears: N 45° W 50.80'.
3. 3/4" X 30" iron rebar set for witness. Witness bears: N 40° E 53.14'.
4. 3/4" X 30" iron rebar set for witness. Witness bears: N 60° E 89.32'.