


Survey Monument Record

TYPE OF MONUMENT 3/4" X 24" IRON BAR
W/ CAP.

CORNER NO. 63
 SECTION 24
 TOWN 6N
 RANGE 1W

FIELD BOOK: 94-06
 PAGE (23)

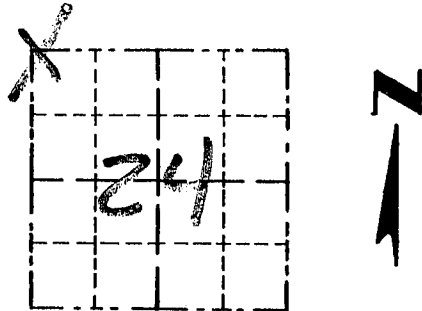


LOCATION
 (Indicated by "X")

BASIS FOR MONUMENT LOCATION

(Use reverse side if necessary)

Show info such as: History of corner, with reference to Vol. and pg., dates, surveyor; exact description of monument replaced; if location computed, by taped or EDM traverse; landowner, remarks, etc.

SEAL:

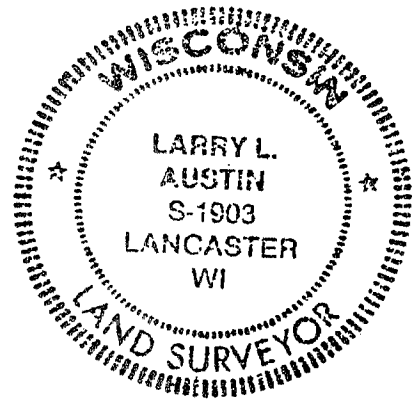

CORNER SET IN 1833 BY SIBLEY. NO RECORD OF CORNER. FOUND SINCE ORIGINAL SURVEY; CORNER WAS SET ONLINE WITH FENCE WEST FOR NORTHING, IN CENTERLINE OF RD NORTH/SOUTH FOR EASTING. VERIFIED ITS LOCATION USING EDM METHODS.

CERTIFIED CORRECT

Larry L. Austin
 Registered Land Surveyor

DATE: 3/28/97

TIE SKETCH

Show at least three (3) ties and monument

LEGEND

- ⊕ 3/4" X 24" IRON BAR SET WITH ALUM CAP.
- 1/2" X 15" IRON BAR SET
- XX EXISTING FENCE

