

U.S. PUBLIC LAND SURVEY MONUMENT RECORD


(As Required By s. A-E 7.08, WI Adm. Code)

History of original corner establishment and subsequent restorations and description of any record, monument, occupational, testimonial or other evidence considered: *There are no recent survey records of this corner. A RR spike found in line with fences east and south and road centerline west was accepted and replaced with a 3/4" x 24" rebar w/ Grant Co. Aluminum cap after an E.D.M. traverse of the section. See section Summary for relationships to other corners.*


Corner was: (Check All That Apply)

- Restored through acceptance of an obliterated evidence location
- Restored through acceptance of a found perpetuated location
- Considered a lost corner and reestablished through lost corner proportionate methods (include a plan view drawing showing distances and directions to other Public Land Survey Corners used for proportioning and determining the corner location)
- Restored or reestablished in a location that differs from a previous restoration or reestablishment (include a plan view drawing and indicate what was set and /or found)

Describe the monument and accessories used to perpetuate the location of this corner. (Include a plan view drawing and indicate what was set and/or found)

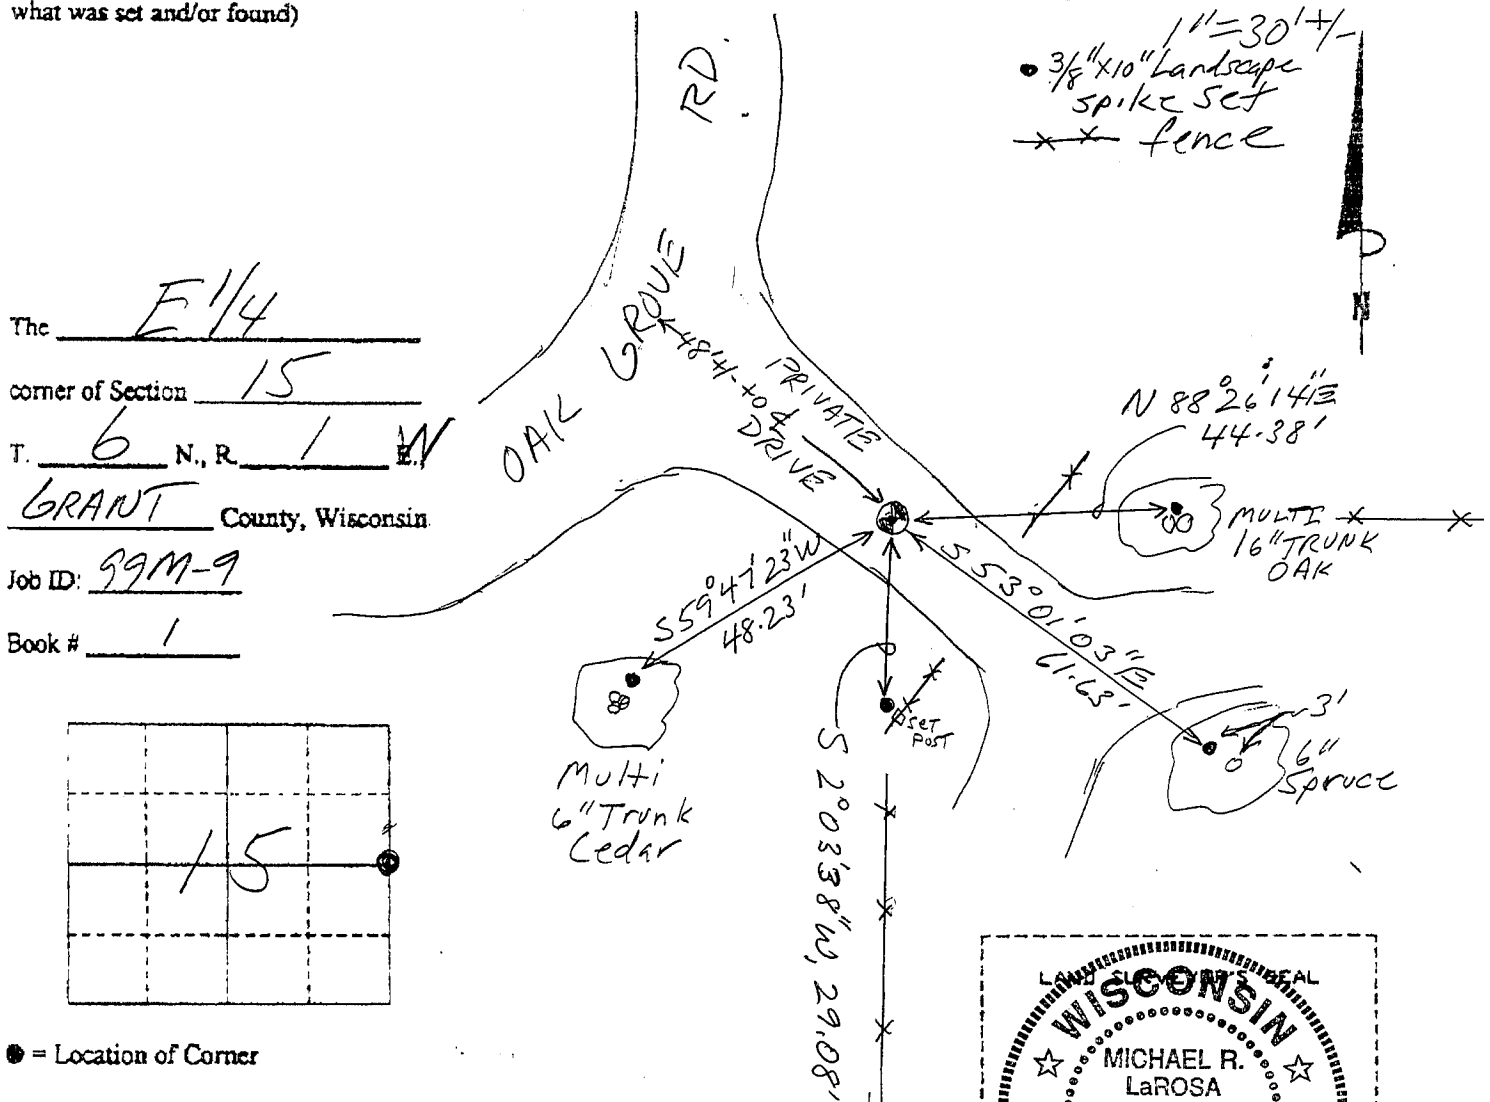


The E 1/4
 corner of Section 15
 T. 6 N., R. 1 W
GRANT County, Wisconsin
 Job ID: 99M-9
 Book # 1

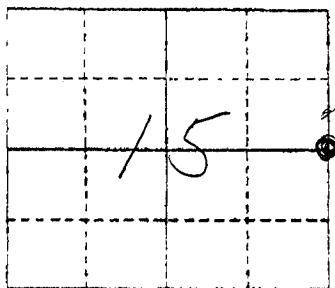

● = Location of Corner

Michael R. LaRosa
 I, Michael R. LaRosa certify that the corner location shown on this record was determined by me or under my direction and control and that this U.S. Public Land Survey Monument Record is correct and complete to the best of my knowledge and belief.

Michael R. LaRosa 10/19/1999
 Signature Date

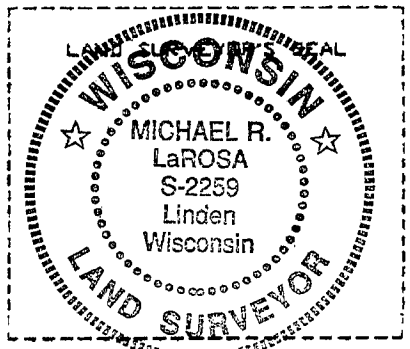

Index No. 58